


BROOKFIELD ROAD (REGIONAL ROAD 51)

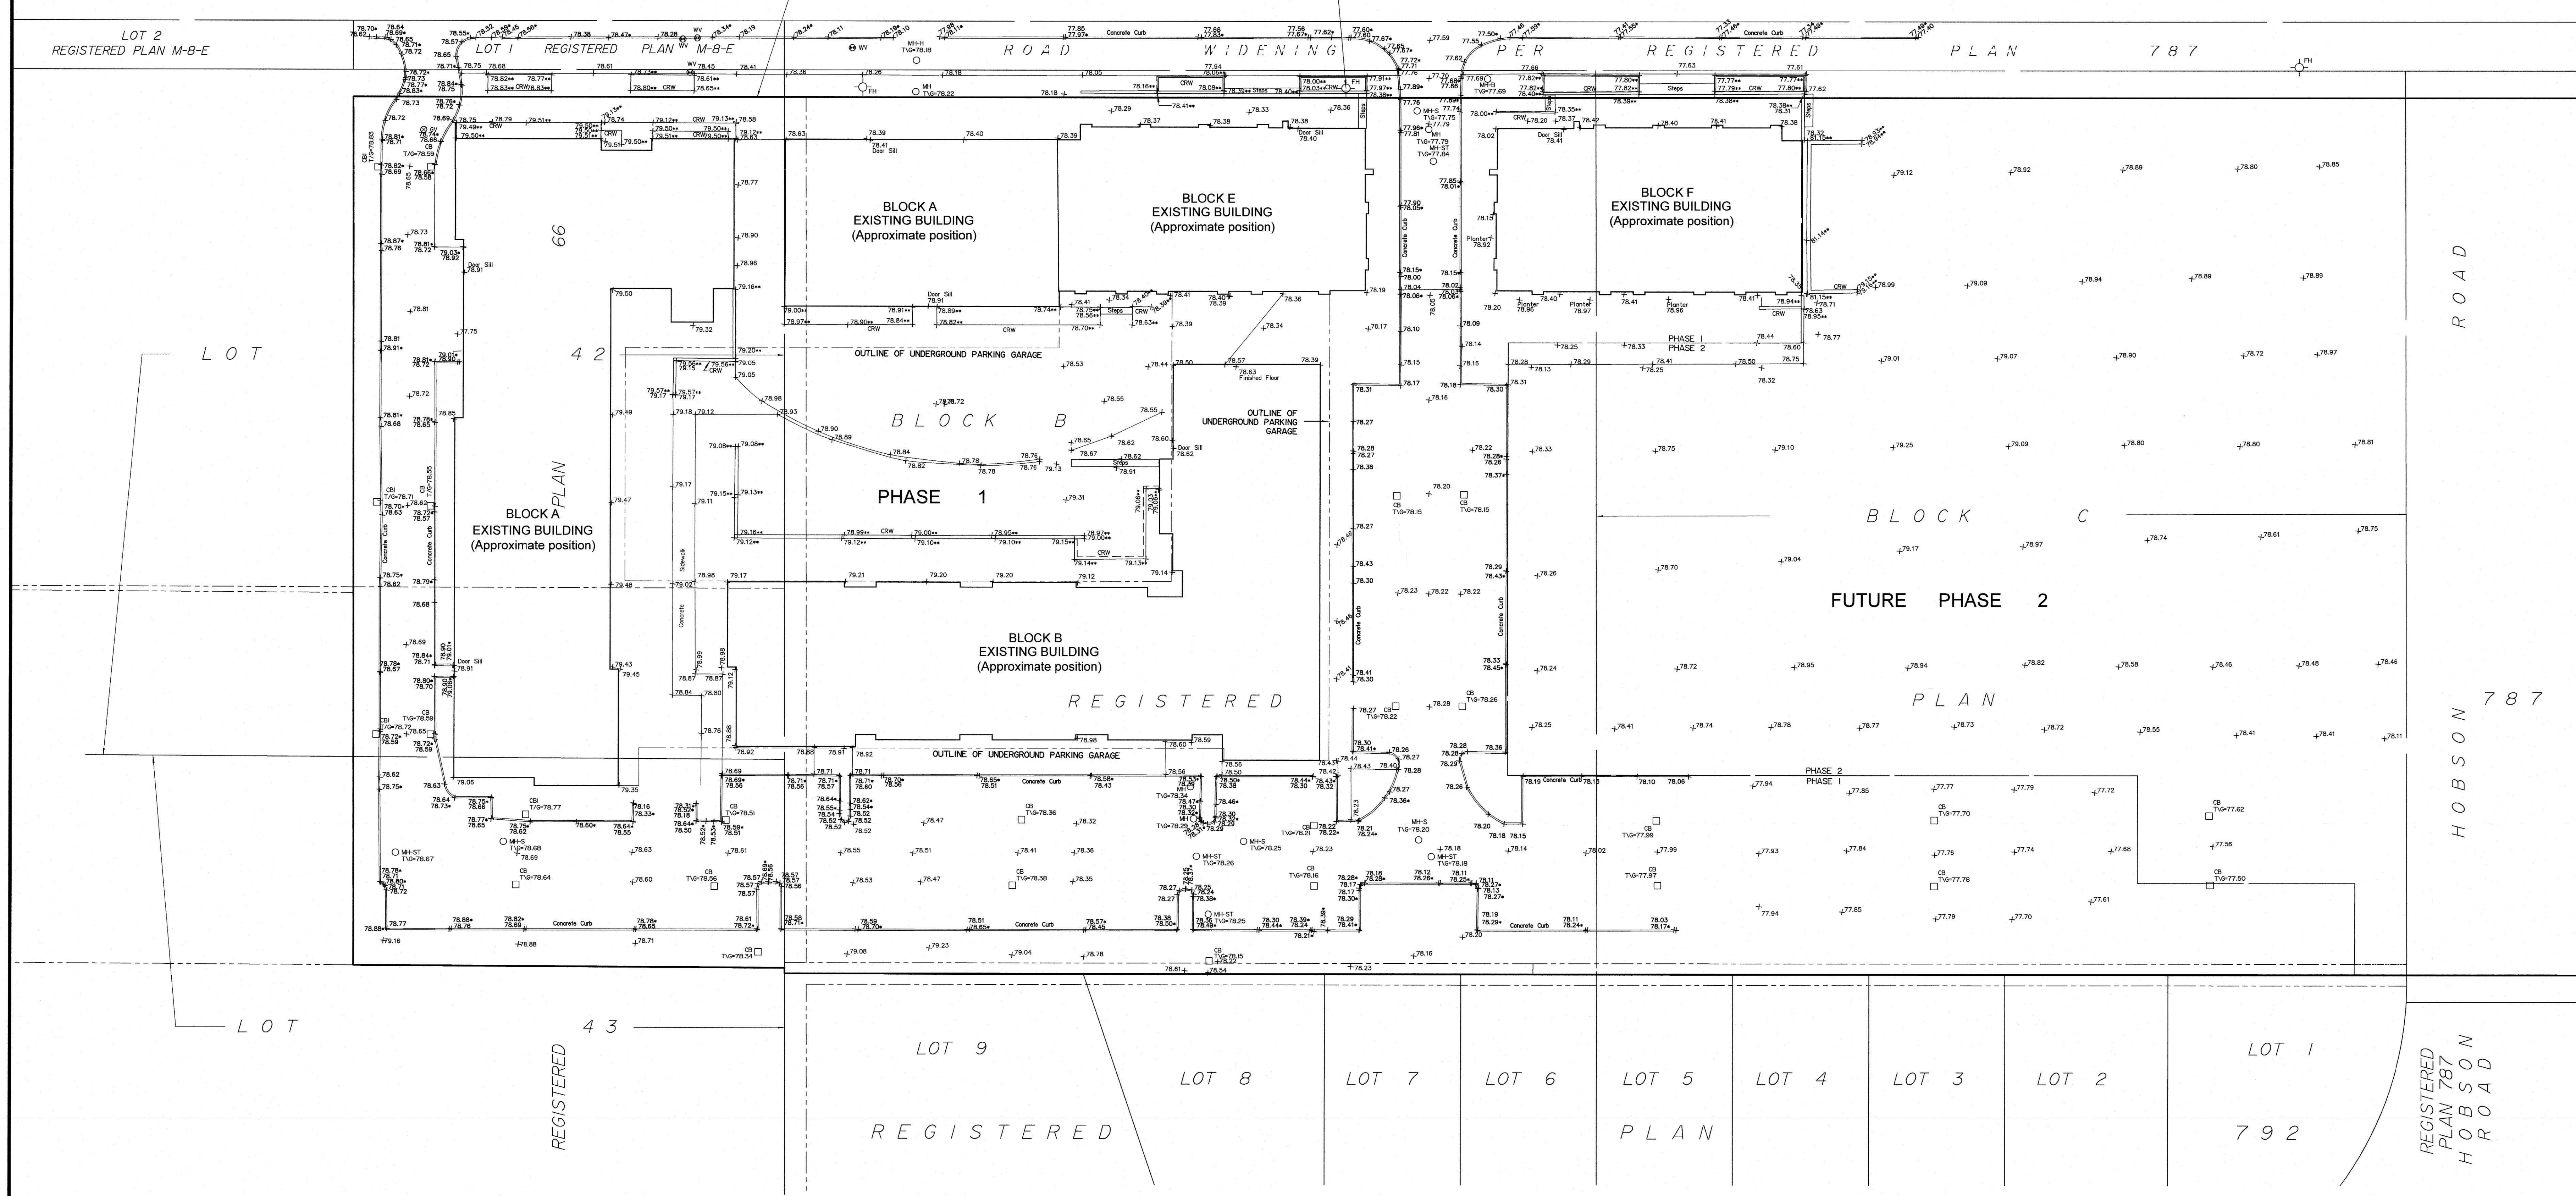

TOPOGRAPHICAL SKETCH SHOWING AS-BUILT GRADES

770 BROOKFIELD ROAD  
PHASE 1  
CITY OF OTTAWA

Prepared by Annis, O'Sullivan, Vollebek Ltd.  
Field Work Completed May 5, 2022

Scale 1:300  
0 3 6 9 12 Metres

Metric  
DISTANCES SHOWN ON THIS PLAN ARE IN METRES AND CAN BE CONVERTED TO FEET BY DIVIDING BY 0.3048

MA 20 2022  
E. H. Hevener  
Ontario Land Surveyor

Caution  
This is NOT a Plan of Survey and shall not be used except for the purpose indicated in the title block.

Notes & Legend

Denotes	
⊙ FH	Fire Hydrant
⊙ W	Water Valve
⊙ M-S	Maintenance Hole (Storm Sewer)
⊙ M-S	Maintenance Hole (Sanitary)
⊙ M-S	Maintenance Hole (Bell Telephone)
⊙ CB	Catch Basin
⊙ CB	Catch Basin Inlet
⊙ M-S	Maintenance Hole (Unidentified)
⊙ E	Location of Elevations
⊙ C	Top of Concrete Curb Elevation
⊙ T	Top of Wall Elevation
T/G	Top of Grade
C/L	Centreline
—	Property Line
CRW	Concrete Retaining Wall

BOUNDARY INFORMATION COMPILED FROM PLAN 4R-28560.

ELEVATION NOTES  
1. Elevations shown are geodetic and are referred to the CGVD28 geodetic datum.  
2. It is the responsibility of the user of this information to verify that the job benchmark has not been altered or disturbed and that its relative elevation and description agrees with the information shown on this drawing.

UTILITY NOTES  
1. This drawing cannot be accepted as acknowledging all of the utilities and it will be the responsibility of the user to contact the respective utility authorities for confirmation.  
2. Only visible surface utilities were located.  
3. A field location of underground plant by the pertinent utility authority is mandatory before any work involving breaking ground, probing, excavating etc.