



1  
A2.1  
NORTH ELEVATION  
1/4"=1'-0"

## GENERAL NOTES

- DO NOT SCALE DRAWINGS.
- THE CONTRACTOR SHALL CHECK AND VERIFY ALL DIMENSIONS ON SITE AND REPORT ALL DISCREPANCIES TO THE ARCHITECT.
- ALL WORK SHALL COMPLY WITH THE ONTARIO BUILDING CODE AND THE REQUIREMENTS OF ALL AUTHORITIES HAVING JURISDICTION.
- THIS DRAWING IS THE EXCLUSIVE PROPERTY OF SHEAN ARCHITECTS INC. COPYRIGHT RESERVED.

## KEY NOTES - ELEVATIONS

### GENERAL

- ALL WINDOWS ARE EXISTING AND ARE TO REMAIN.
- NEW EXTERIOR DOORS TO REPLACE WINDOWS. REFER TO PLANS FOR MIN. DIMENSIONS.

### MATERIALS

- EBR EXISTING BRICK  
EST EXISTING STONE  
LT LANDSCAPED AND STEPS  
MS PRE-FINISHED METAL SILL FLASHING  
MSC PRE-FINISHED METAL SILL FLASHING - CONCEALED  
PG CEMENT PARGING  
BR NEW BRICK INFILL - MATCH EXISTING  
WS WOOD EXTERIOR STAIR  
STL STEEL BEAMS TO SUPPORT CANTILEVERED WALKWAY. DIMENSIONS AND QUANTITY TO BE DETERMINED BY STRUCTURAL ENGINEER.

01 AUG. 19, 2020

No. DATE DESCRIPTION

ARCHITECT'S SEAL: PROJECT NORTH:




46 GARLAND AVE., OTTAWA, K1Y 2A7 613.706.1263

PROJECT:  
EMBASSY  
4 RANGE ROAD  
OTTAWA, ON

DRAWING TITLE:  
AS BUILT  
NORTH ELEVATION

DATE: 2020/08/18  
SCALE: 1/4" = 1'-0"  
DRAWN BY: AT  
JOB No: 20-069

A2.1

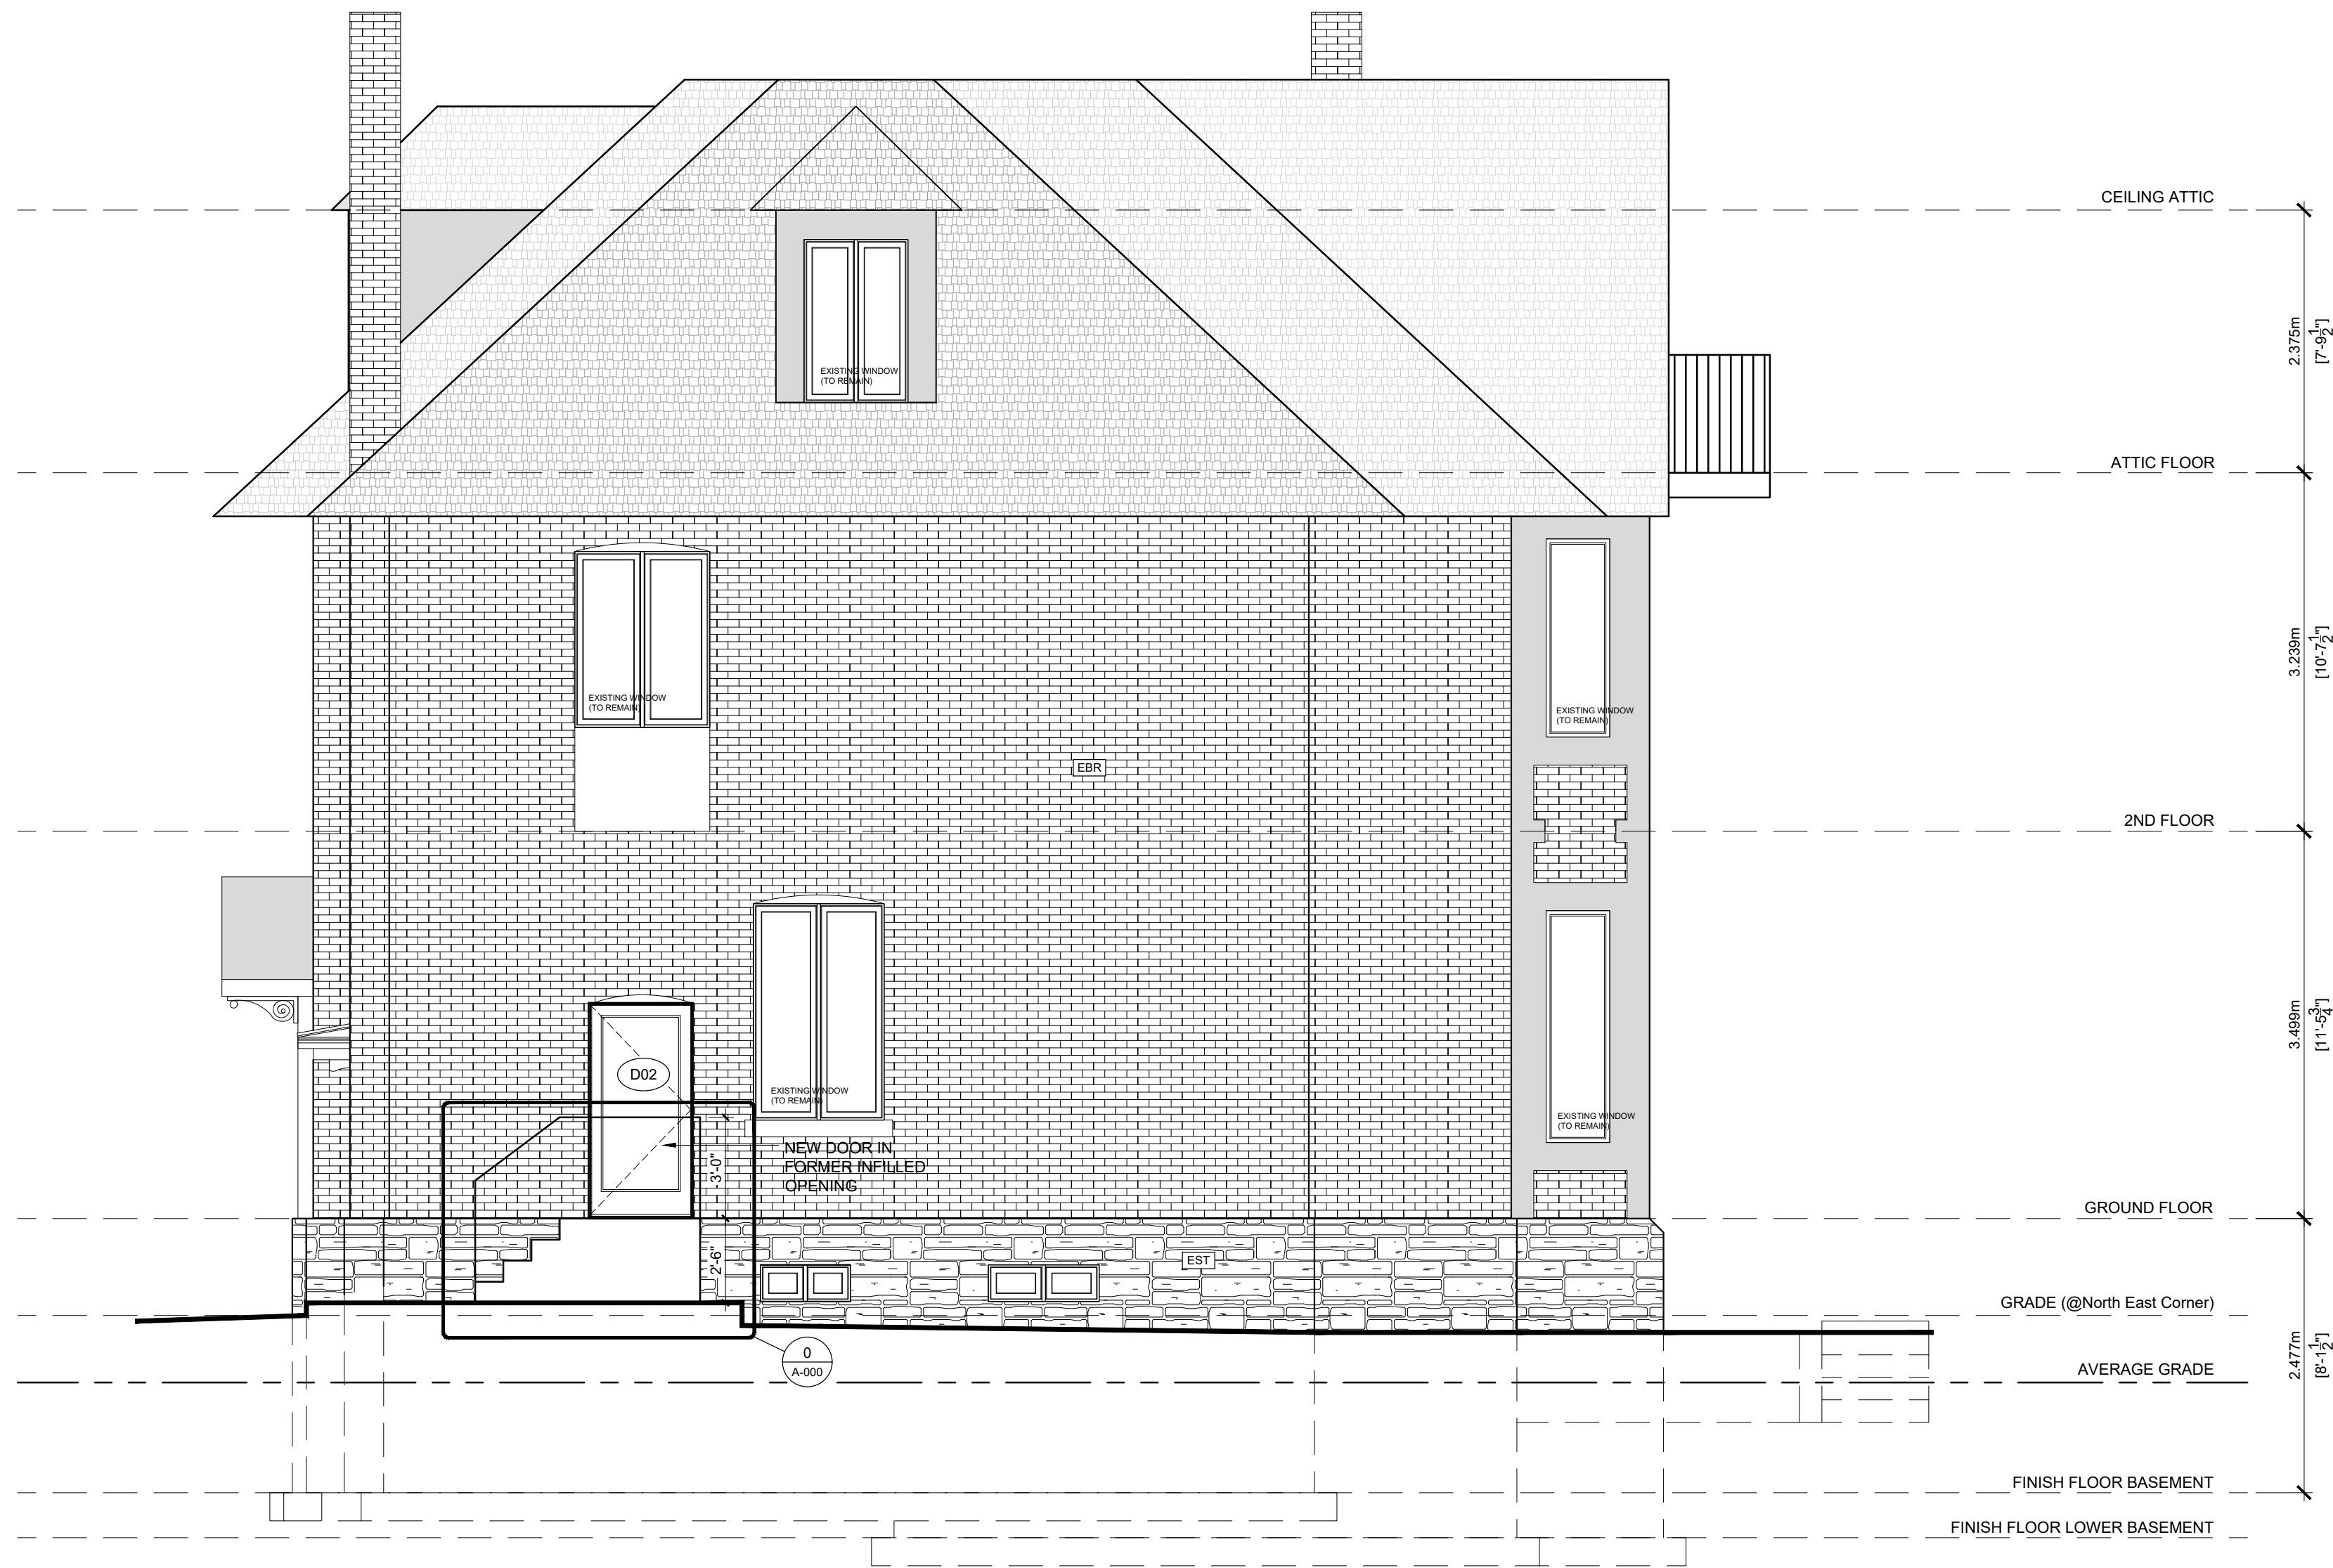

1 WEST ELEVATION  
A2.2 1/4"=1'-0"

## GENERAL NOTES

- DO NOT SCALE DRAWINGS.
- THE CONTRACTOR SHALL CHECK AND VERIFY ALL DIMENSIONS ON SITE AND REPORT ALL DISCREPANCIES TO THE ARCHITECT
- ALL WORK SHALL COMPLY WITH THE ONTARIO BUILDING CODE AND THE REQUIREMENTS OF ALL AUTHORITIES HAVING JURISDICTION.
- THIS DRAWING IS THE EXCLUSIVE PROPERTY OF SHEAN ARCHITECTS INC. COPYRIGHT RESERVED.

## KEY NOTES - ELEVATIONS

### GENERAL

- ALL WINDOWS ARE EXISTING AND ARE TO REMAIN.
- NEW EXTERIOR DOORS TO REPLACE WINDOWS. REFER TO PLANS FOR MIN. DIMENSIONS.

### MATERIALS

EBR EXISTING BRICK  
EST EXISTING STONE

LT LANDSCAPED AND STEPS

MS PRE-FINISHED METAL SILL FLASHING  
MSC PRE-FINISHED METAL SILL FLASHING - CONCEALED

PG CEMENT PAVING

BR NEW BRICK INFILL - MATCH EXISTING

WS WOOD EXTERIOR STAIR

STL STEEL BEAMS TO SUPPORT CANTILEVERED WALKWAY. DIMENSIONS AND QUANTITY TO BE DETERMINED BY STRUCTURAL ENGINEER.

01 AUG. 19, 2020

No. DATE DESCRIPTION

ARCHITECT'S SEAL: PROJECT NORTH:



PROJECT:  
EMBASSY  
4 RANGE ROAD  
OTTAWA, ON

DRAWING TITLE:  
AS BUILT  
WEST ELEVATION

DATE: 2020/08/18	DRAWING No:
SCALE: 1/4" = 1'-0"	
DRAWN BY: AT	
JOB No: 20-069	

PROPERTY LINE



1 SOUTH ELEVATION  
A2.3 1/4"=1'-0"

## GENERAL NOTES

- DO NOT SCALE DRAWINGS.
- THE CONTRACTOR SHALL CHECK AND VERIFY ALL DIMENSIONS ON SITE AND REPORT ALL DISCREPANCIES TO THE ARCHITECT.
- ALL WORK SHALL COMPLY WITH THE ONTARIO BUILDING CODE AND THE REQUIREMENTS OF ALL AUTHORITIES HAVING JURISDICTION.
- THIS DRAWING IS THE EXCLUSIVE PROPERTY OF SHEAN ARCHITECTS INC. COPYRIGHT RESERVED.

## KEY NOTES - ELEVATIONS

### GENERAL

- ALL WINDOWS ARE EXISTING AND ARE TO REMAIN.
- NEW EXTERIOR DOORS TO REPLACE WINDOWS. REFER TO PLANS FOR MIN. DIMENSIONS.

### MATERIALS

- EBR EXISTING BRICK  
EST EXISTING STONE  
LT LANDSCAPED AND STEPS  
MS PRE-FINISHED METAL SILL FLASHING  
MSC PRE-FINISHED METAL SILL FLASHING - CONCEALED  
PG CEMENT PARGING  
BR NEW BRICK INFILL - MATCH EXISTING  
WS WOOD EXTERIOR STAIR  
STL STEEL BEAMS TO SUPPORT CANTILEVERED WALKWAY. DIMENSIONS AND QUANTITY TO BE DETERMINED BY STRUCTURAL ENGINEER.

No.	DATE	DESCRIPTION
01	AUG. 19, 2020	

ARCHITECT'S SEAL:	PROJECT NORTH:

**SHEAN**  
ARCHITECTS  
46 GARLAND AVE., OTTAWA, K1Y 2A7 613.706.1263

PROJECT:  
**EMBASSY**  
4 RANGE ROAD  
OTTAWA, ON


DRAWING TITLE:  
**AS BUILT**  
SOUTH ELEVATION

DATE:	2020/08/18	DRAWING No:	
SCALE:	1/4" = 1'-0"		
DRAWN BY:	AT		
JOB No:	20-069		




1  
A2.4  
1/4"=1'-0"

EXTERIOR STAIR

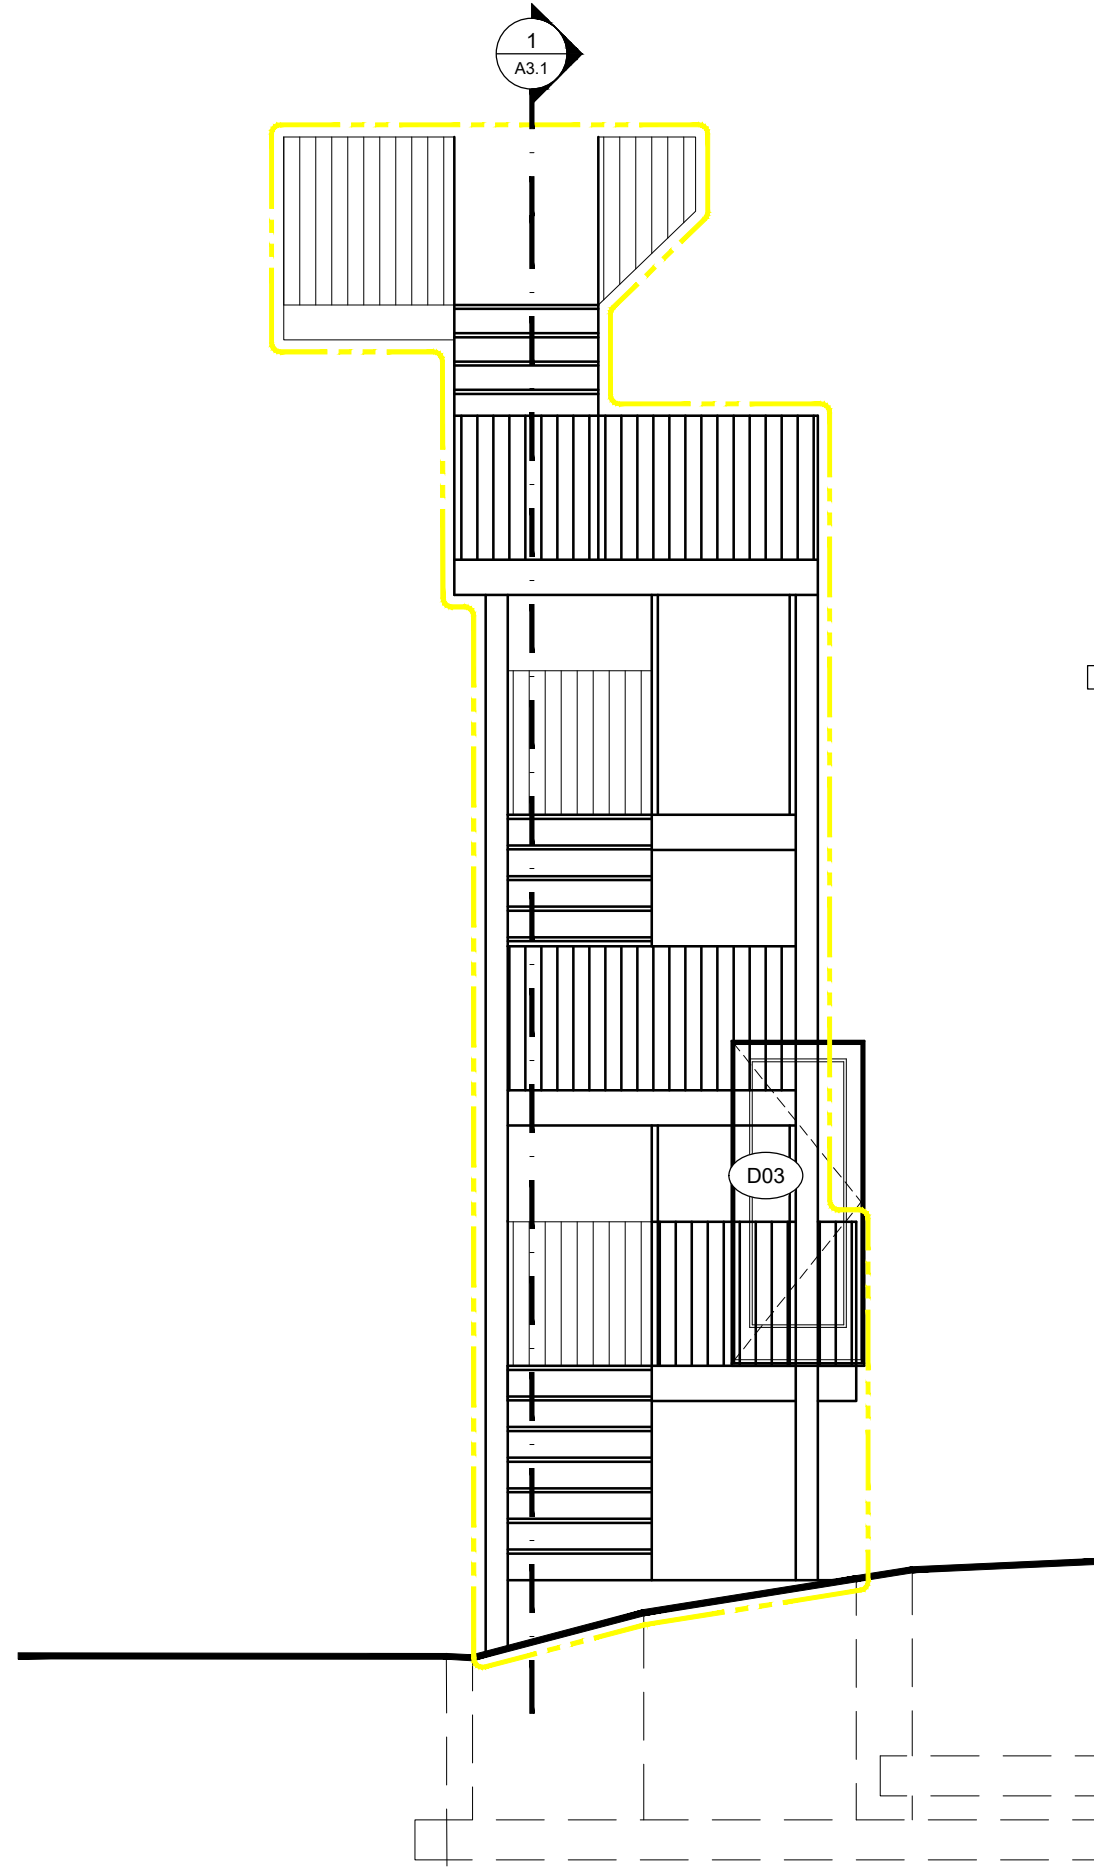

1  
A2.4  
1/4"=1'-0"

EAST ELEVATION

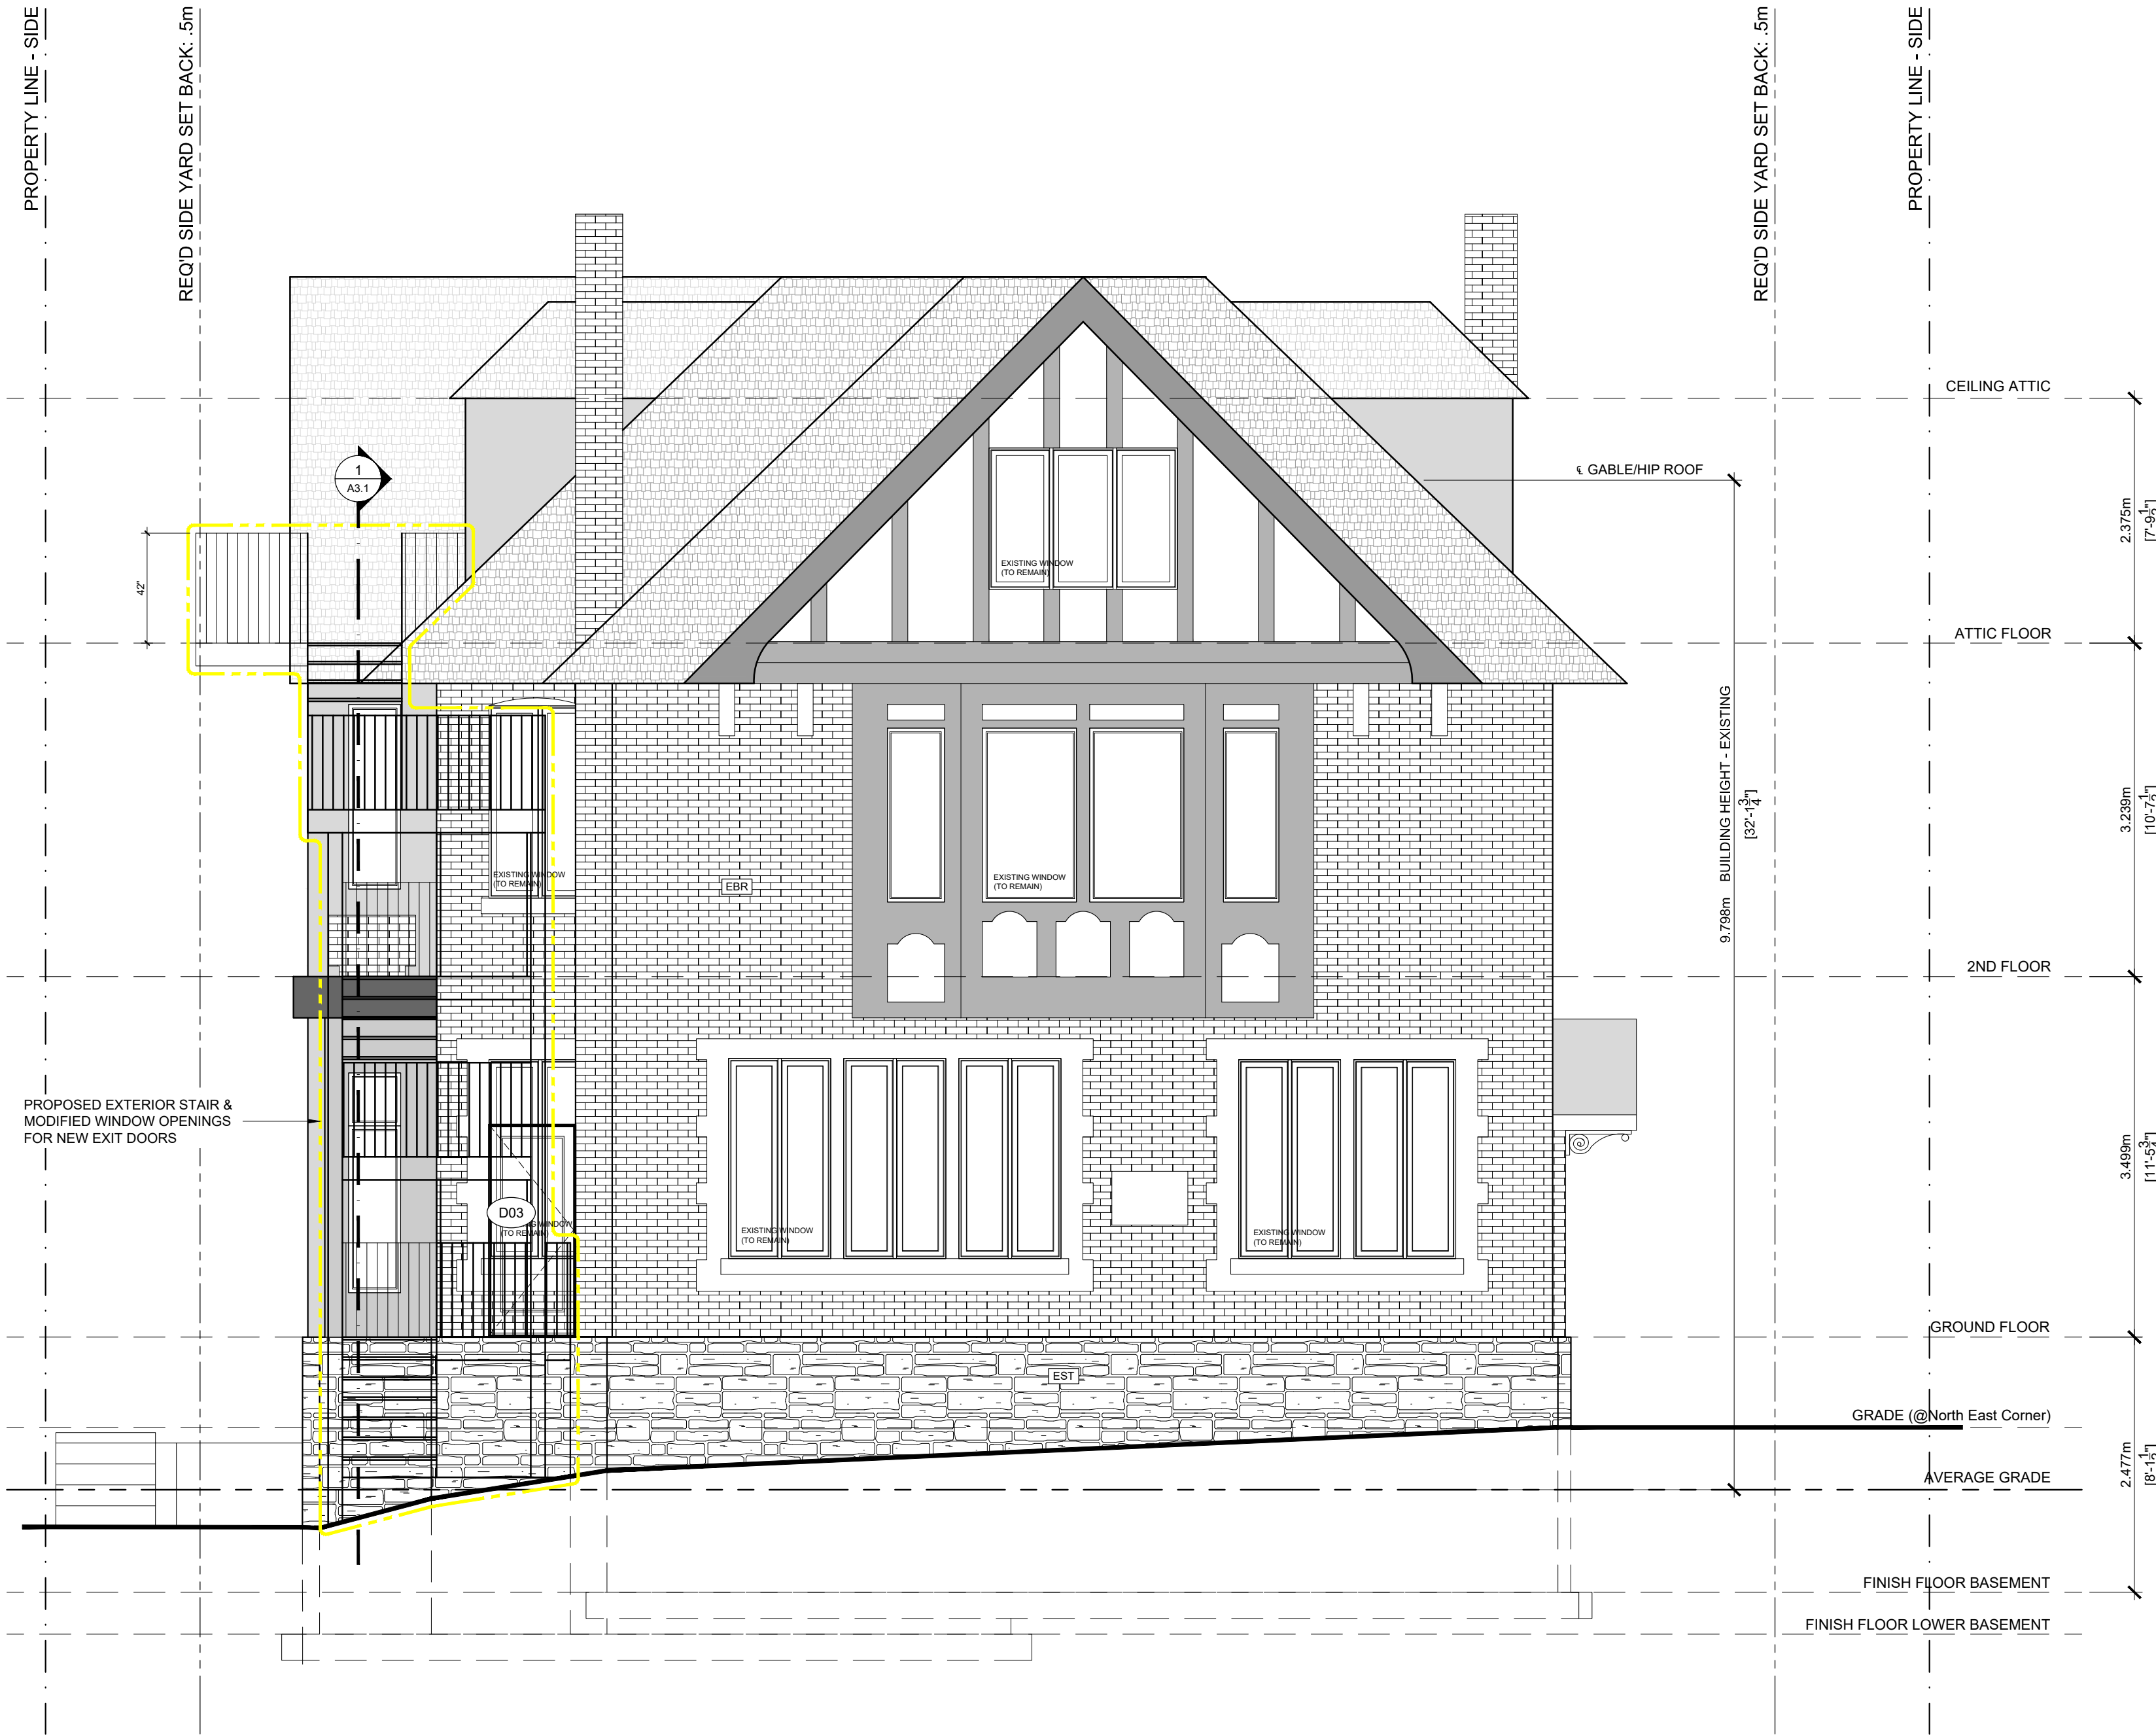

## GENERAL NOTES

- DO NOT SCALE DRAWINGS.
- THE CONTRACTOR SHALL CHECK AND VERIFY ALL DIMENSIONS ON SITE AND REPORT ALL DISCREPANCIES TO THE ARCHITECT.
- ALL WORK SHALL COMPLY WITH THE ONTARIO BUILDING CODE AND THE REQUIREMENTS OF ALL AUTHORITIES HAVING JURISDICTION.
- THIS DRAWING IS THE EXCLUSIVE PROPERTY OF SHEAN ARCHITECTS INC. COPYRIGHT RESERVED.

### KEY NOTES - ELEVATIONS

#### GENERAL

- ALL WINDOWS ARE EXISTING AND ARE TO REMAIN.
- NEW EXTERIOR DOORS TO REPLACE WINDOWS. REFER TO PLANS FOR MIN. DIMENSIONS.

#### MATERIALS

EBR EXISTING BRICK  
EST EXISTING STONE

LT LANDSCAPED AND STEPS

MS PRE-FINISHED METAL SILL FLASHING  
MSC PRE-FINISHED METAL SILL FLASHING - CONCEALED

PG CEMENT PARGING

BR NEW BRICK INFILL - MATCH EXISTING

WS WOOD EXTERIOR STAIR

STL STEEL BEAMS TO SUPPORT CANTILEVERED WALKWAY. DIMENSIONS AND QUANTITY TO BE DETERMINED BY STRUCTURAL ENGINEER.

01 AUG. 19, 2020

No. DATE DESCRIPTION

ARCHITECT'S SEAL: PROJECT NORTH:



PROJECT:  
EMBASSY  
4 RANGE ROAD  
OTTAWA, ON

DRAWING TITLE:  
AS BUILT  
EAST ELEVATION

DATE: 2020/08/18  
SCALE: 1/4" = 1'-0"  
DRAWN BY: AT  
JOB No: 20-069

DRAWING No: