
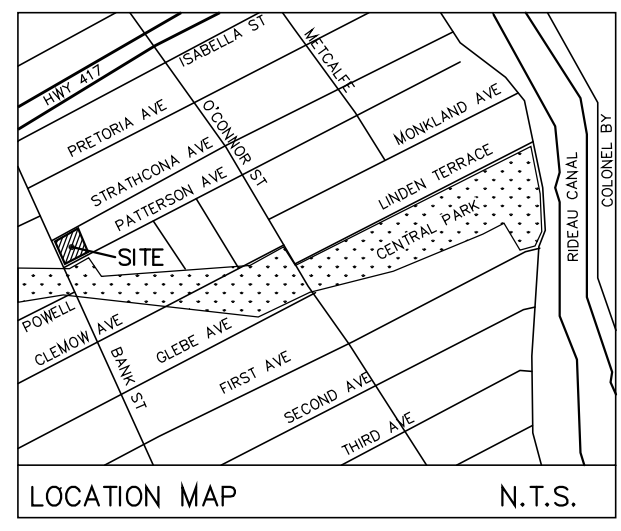


1 SITE PLAN
SCALE 1:100

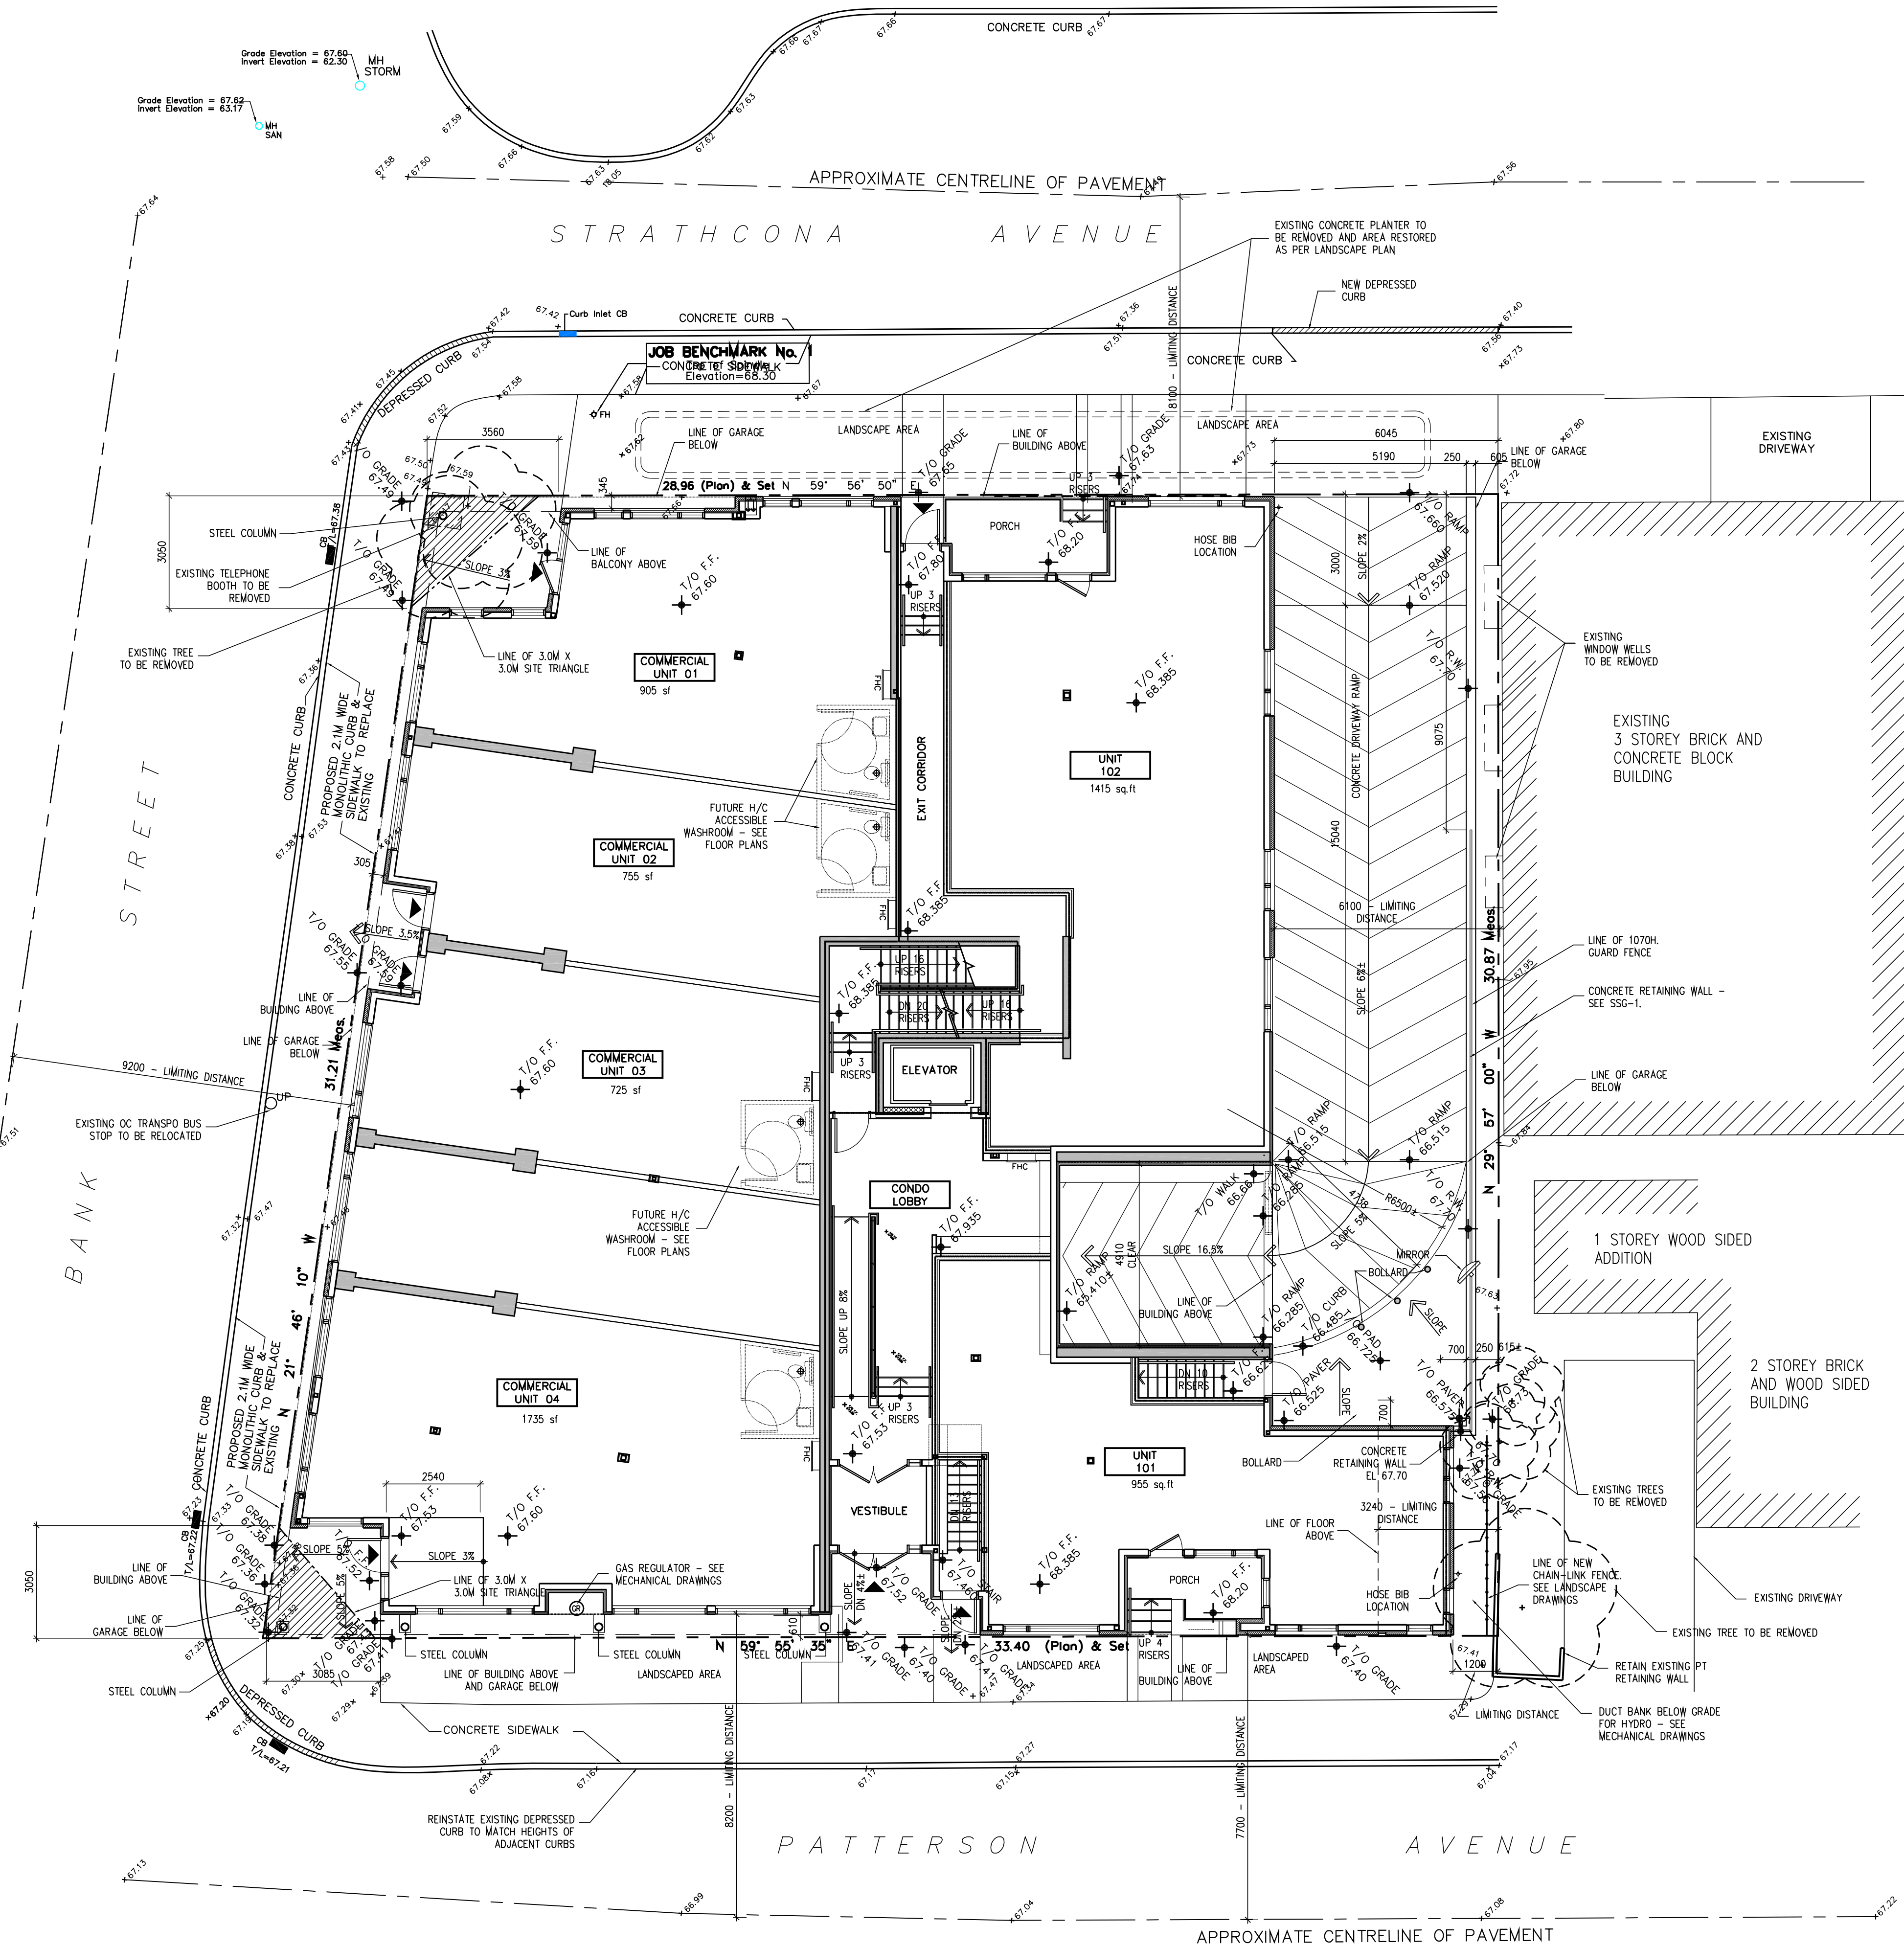

LEGAL DESCRIPTION

LOTS 9 AND 10 (EAST BANK STREET LOTS)
REGISTERED PLAN 46293
CITY OF OTTAWA
REGIONAL MUNICIPALITY OF OTTAWA CARLETON

DEVELOPMENT INFO.

ZONING: CN5 H(10.7) F2.0
SITE AREA: 10,366 S.F. (963 S.M.)
BLDG AREA: COMM. - 4,120 S.F. (383 S.M.)
RES. - 26,405 S.F. (2,450 S.M.)
OF RES. UNITS: 21 (525 S.F. TO 1,550 S.F.)
PARKING: U/G 21

NOTES

1. FOR CITY CURB CUTS, REPAIRS, AND REPLACEMENT SEE SITE SERVICES PLAN SSG-1.
2. FOR CITY SIDEWALK WORK, SEE SITE SERVICES PLAN SSG-1.
3. FOR LANDSCAPE AREAS, SEE LANDSCAPE PLAN L1.

LEGEND

- NEW GRADES & ELEVATIONS
- EXISTING GRADES & ELEVATIONS
- UTILITY POLE
- FIRE HYDRANT
- HATCHED AREA INDICATES SITE TRIANGLE

It is the responsibility of the appropriate Contractor to check and verify all dimensions on site and report all errors and/or omissions to the Architect.
All Contractors must comply with all pertinent codes and by-laws.
Do not scale drawings.
This drawing may not be used for construction until signed.
Architect's copyright reserved.

DEVELOPER:
DOMICILE DEVELOPMENTS INC.
371-A RICHMOND ROAD, SUITE 1
OTTAWA, ON, K2A 0E7

NOTE: INITIAL SITE PLAN AND PRELIMINARY ARCHITECTURAL DESIGN WAS PRODUCED IN THE OFFICES OF:
JAMES A. COLIZZA ARCHITECT INC.
76 CHAMBERLAIN AVE
OTTAWA, ON, K1S 1V9

no	date	revision
14	MAR 18 2009	ISSUED - AS-BUILT DRAWINGS
13	JAN 09 2009	REVISED CONSTRUCTION
12	NOV 29 2007	REVISED CONSTRUCTION
11	OCT 19 2007	ISSUED FOR CONSTRUCTION
10	SEPT 07 2007	ISSUED FOR BUILDING PERMIT
9	AUG 15 2007	ISSUED - FOUNDATION PERMIT
8	MAY 30 2007	RE-ISSUED FOR PRICING
7	MAR 05 2007	REVISED - S.P.A. APPROVAL
6	FEB 28 2007	GENERAL REVIEW
5	FEB 01 2007	SPA - FINAL REVIEW
4	JAN 12 2007	REVISED - S.P.A. SUBMISSION
3	03 JAN 07	REVISED FOR S.P.A. SUBMISSION
2	11 DEC 06	REVISED - PRICING
1	08 DEC 06	ISSUED FOR PRICING

north

professional stamp

ALCAIDE WEBSTER
ARCHITECTS INC
1755 Woodward Drive
Ottawa, ON K2C 0P9 www.awa-arch.ca

ARCHITECTURE URBAN DESIGN PLANNING
DESIGN BUILD PROJECT MANAGEMENT

consultant

project
615 BANK ST
DOMICILE DEVELOPMENTS
OTTAWA, ON

drawn JG	checked VA
date 01 NOVEMBER 09	project no. 06-64

drawing title
SITE PLAN

revision 14	drawing no. SP-1
----------------	----------------------------