


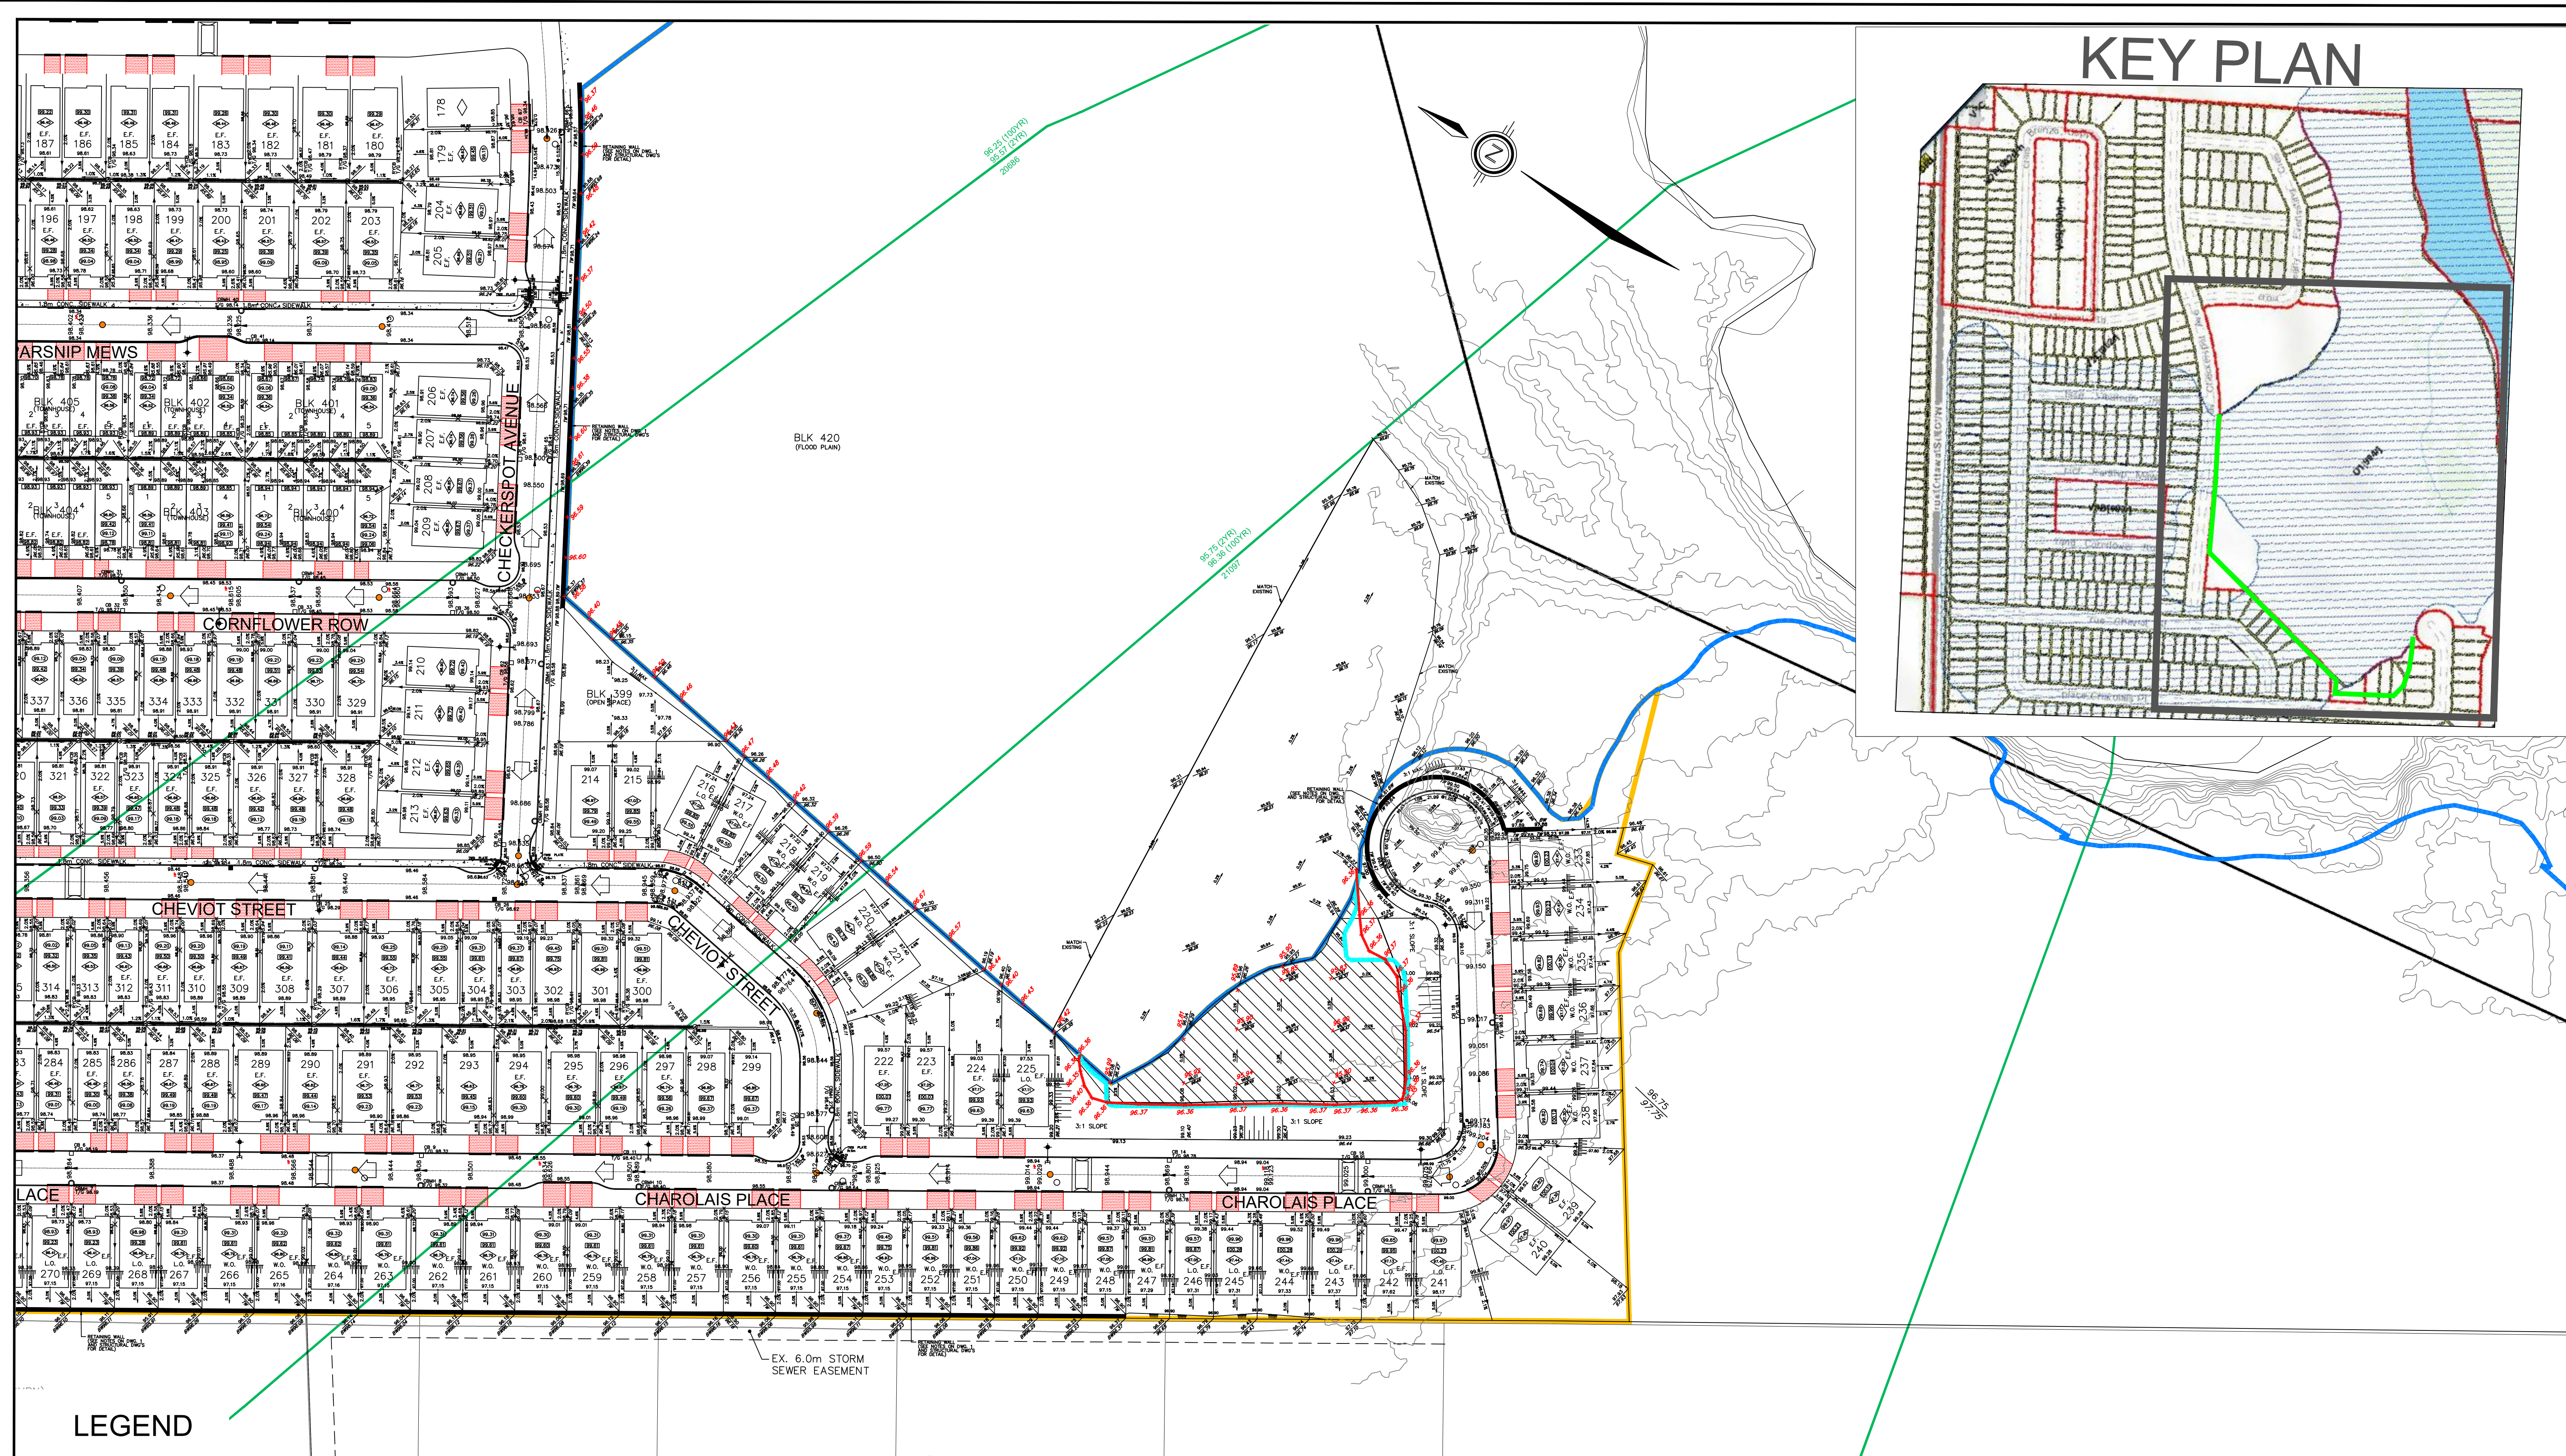

103.45

102.73

PROPOSED ELEVATION

EXISTING ELEVATION

96.36

ASBUILT FLOODPLAIN BOUNDARY

EXISTING FLOODPLAIN BOUNDARY

BASED ON DETAILED SITE SURVEY

PROPOSED NEW FLOODPLAIN

96.36

ASBUILT ELEVATION

ASBUILT FLOODPLAIN BOUNDARY

BASED ON DETAILED SITE SURVEY

RICHMOND MEADOWS PH 3, 4 & 5

NEW FLOODPLAIN PROPOSED

GRADING PLAN

DSEL

120 Iber Road, Unit 103

Stittsville, ON, K2S 1E9

Tel. (613) 836-0856

Fax. (613) 836-7183

www.DSEL.ca

PROJECT No.:

22-1288

SCALE:

1:750

DATE:

MAY 2025

FIGURE:

1