


SURVEYOR'S REAL PROPERTY REPORT
PART 1 - PLAN OF SURVEY

LOT 41
REGISTERED PLAN 263
CITY OF OTTAWA

Stantec Geomatics Ltd.

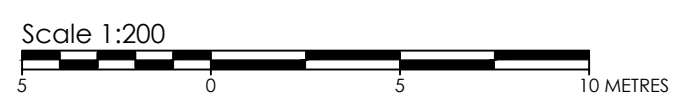

© Copyright 2021 Stantec Geomatics Ltd. The reproduction, alteration or use of this REPORT in whole or in part without the express permission of Stantec Geomatics Ltd. is STRICTLY PROHIBITED.

METRIC CONVERSION

DISTANCES AND COORDINATES SHOWN ON THIS PLAN ARE IN METRES AND CAN BE CONVERTED TO FEET BY DIVIDING BY 0.3048

GRID SCALE CONVERSION

DISTANCES ARE GROUND AND CAN BE CONVERTED TO GRID BY MULTIPLYING BY THE COMBINED SCALE FACTOR OF 0.999965.

BEARING NOTE

BEARINGS ARE GRID, DERIVED FROM CAN-NET VRS NETWORK GPS OBSERVATIONS ON NCC HORIZONTAL CONTROL MONUMENTS 19773035 AND 19680191, CENTRAL MERIDIAN, 76° 30' WEST LONGITUDE MTM ZONE 9, NAD83 (ORIGINAL).

19773035 N:5006060.42 E:324888.04
19680191 N:5033564.26 E:388064.94

NOTE

THIS PLAN OF SURVEY IS TO BE READ IN CONJUNCTION WITH THE REPORT SUMMARY NOTED AS PART 2 HEREON.
THIS REPORT CAN ONLY BE UPDATED BY THIS OFFICE. NO ADDITIONAL PRINTS OF THIS ORIGINAL REPORT WILL BE ISSUED SUBSEQUENT TO THE DATE OF CERTIFICATION.
ALL TIES TO CURVED BOUNDARY ARE RADIAL TO ARC.
RISK OF UNDERGROUND SERVICES, MONUMENTATION PLANTED ACCORDINGLY.

PART 2

This Report was prepared for MATTHEW PAMENTER, AQA MAKIK and the undersigned accepts no responsibility for the use by other parties.

- REGISTERED RIGHTS-OF-WAY/EASEMENTS**
No rights-of-way or easements were found to be registered against the subject property.
- PROPERTY IMPROVEMENTS**
There is a 2 storey dwelling situated wholly within the subject lands.
- COMPLIANCE WITH MUNICIPAL ZONING BYLAWS**
Compliance is not certified by this report.
- ADDITIONAL REMARKS**
Note the locations of fences along the northerly, westerly and southerly limits of the property.

LEGEND

Symbol	DENOTES	FOUND MONUMENTS
■	"	FOUND MONUMENTS
□	"	SET MONUMENTS
IB	"	IRON BAR
IBØ	"	ROUND IRON BAR
SIB	"	STANDARD IRON BAR
SSIB	"	SHORT STANDARD IRON BAR
CC	"	CUT CROSS
CP	"	CONCRETE PIN
WIT	"	WITNESS
PIN	"	PROPERTY IDENTIFICATION NUMBER
MEAS	"	MEASURED
INST	"	INSTRUMENT
PROP	"	PROPORTIONED
OU	"	ORIGIN UNKNOWN
SG	"	STANTEC GEOMATICS LTD.
P1	"	PLAN BY 1692 DATED SEPT 10, 2020
P2	"	PLAN 4R-15898
P3	"	PLAN 4R-29565
647	"	H. R. FARLEY, O.L.S.
857	"	FAIRHALL & MOFFATT LTD.
1692	"	FARLEY, SMITH & DENIS SURVEYING LTD.
ACU	"	AIR CONDITIONING UNIT
CB	"	CATCH BASIN
GSR	"	GAS SERVICE REGULATOR
MHSA	"	MAINTENANCE HOLE SANITARY
MHST	"	MAINTENANCE HOLE STORM
UP	"	UTILITY POLE
WV	"	WATER VALVE

SURVEYOR'S CERTIFICATE

- I CERTIFY THAT:
- THIS SURVEY AND PLAN ARE CORRECT AND IN ACCORDANCE WITH THE SURVEYS ACT, THE SURVEYORS ACT AND THE REGULATIONS MADE UNDER THEM.
 - THE SURVEY WAS COMPLETED ON THE 10th DAY OF SEPTEMBER, 2021.

Oct. 12, 2021
DATE

Francis Lau
FRANCIS LAU
ONTARIO LAND SURVEYOR

SRO MAP COORD.=X=363479.23 Y=5028532.48

Stantec Geomatics Ltd.
CANADA LANDS SURVEYORS
ONTARIO LAND SURVEYORS
1331 CLYDE AVENUE, SUITE 400
OTTAWA, ONTARIO, K2C 3G4
TEL. 613.722.4420
stantec.com

DRAWN: TMT CHECKED: FL PM: FL FIELD: CA PROJECT No.: 161614445-110

