



**re: Grading and Site Servicing Plan Review**  
**Proposed Self Storage Development**  
**75 Michael Cowpland Drive – Ottawa, Ontario**

**to:** Huntington Properties – **Mr. Mathieu Desjardins** –  
[mdesjardins@huntingtonproperties.ca](mailto:mdesjardins@huntingtonproperties.ca)

**to:** IBI Group – **Ms. Amy Zhuang** – [Amy.Zhuang@ibigroup.com](mailto:Amy.Zhuang@ibigroup.com)

**date:** November 24, 2023

**file:** PG3798-MEMO.02 Revision 3

---

Further to your request and authorization, Paterson Group (Paterson) prepared the current memorandum to document our review of the grading and servicing plans, and to provide associated recommendations from a geotechnical perspective for the aforementioned project. The following memorandum should be read in conjunction with the current Geotechnical Investigation Report Paterson Group Report PG3798-2 Revision 3, dated November 23, 2022.

### **Site Servicing Plan Review**

Paterson reviewed the following site servicing plans prepared by IBI Group for the aforementioned development:

- General Plan of Services – Project No. 135470, Sheet No. C-001, Revision 6, dated November 13, 2023.
- Cross Sections – Project No. 135470, Sheet No. C-011, Revision 6, dated November 13, 2023.

Based on our review of the above noted site service plans, the majority of the design details are considered to be acceptable from a geotechnical perspective. All proposed service pipes are sufficiently covered by adequate soil cover with no frost protection required.

### **Thickened Edge Slab Lateral Support Zone Lowering and Foundation Insulation**

Upon discussions with the design team, the proposed thickened edge slabs are now proposed to be placed on vertical, concrete in-filled trenches where adjacent service pipes are proposed with the lateral support zone of the proposed structures. These trenches would lower the lateral support zone of the slabs below the service trenches ensuring that the proposed buildings are protected should future excavation be required for the proposed services for maintenance purposes.





Due to the anticipated depth and proximity of the proposed service pipes to the proposed thickened edge slab footprints, it is expected the lateral support zones for the proposed structures will be negatively impacted by the service installation works. Further, future maintenance that could be considered throughout the proposed service alignments would require trenches that would impact the proposed buildings lateral support zones. Based on this, it is recommended to lower the lateral support zones for thickened edge footings located adjacent to impacting service alignments. This may be accomplished by sub-excavating a near-vertical trench located directly below the overlying footing footprint and in-filled with minimum 17 MPa lean-concrete.

It is recommended the near-vertical trenches extend a minimum of 150 mm horizontally beyond the overlying footing footprint. Based on our review, the lean-concrete trench detail has been incorporated satisfactorily into the above-noted site servicing plans. The recommended perimeter thickened-edge slab foundation insulation detail is depicted below for the proposed storage structures and has been incorporated satisfactorily in the above-noted site servicing plans. The placement of the lean-concrete trench and rigid insulation should be reviewed and approved by Paterson personnel at the time of construction.

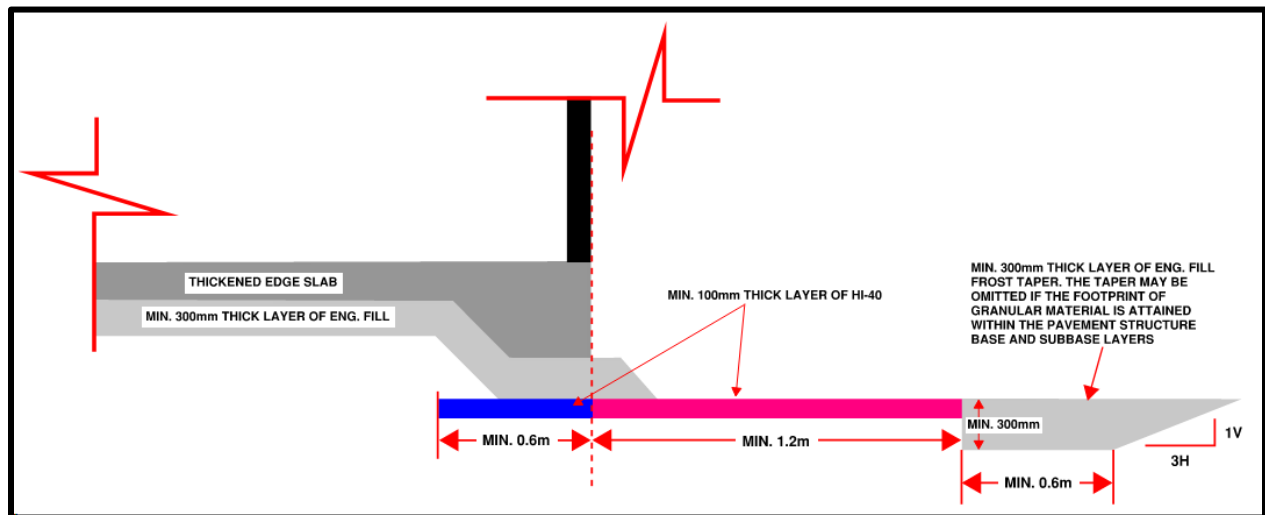


Figure 1 - Proposed Thickened Edge Slab Foundation Insulation Detail

## Stormtech Underground Storage Tanks

Paterson reviewed the locations and founding depths for the proposed Stormtech Underground Storage MC-3500 units to be located throughout the subject site. Based on our review of the subsurface profile and associated geotechnical information for the subject site, the stormwater chambers will be founded upon a native, in-situ, stiff brown silty clay layer. Further, it is expected the proposed tank invert will be located above the seasonally high and the long-term groundwater table throughout the subject site. Based on this, it is not anticipated localized dewatering of the groundwater table will take place throughout the subject site by the implementation of the proposed tanks. Therefore, the proposed storage tanks considered acceptable from a geotechnical perspective.



## Grading Plan Review

Paterson reviewed the following grading plans prepared by IBI Group for the aforementioned development:

- ❑ Grading Plan – Project No. 135470, Sheet No. C-200, Revision 6, dated November 13, 2023.

Based on our review of the aforementioned grading plan, the proposed grades around the proposed buildings and throughout the subject site are within the permissible grade raise restriction provided. Based on this, since grade raises are within our recommended grade raise restriction no lightweight fill will be required to accommodate the proposed grading. Therefore, the proposed grading is considered acceptable from a geotechnical perspective.

We trust that this information satisfies your immediate requirements.

Best Regards,

**Paterson Group Inc.**

Drew Petahtegoose, P.Eng.



Faisal I. Abou-Seido, P.Eng.





# PG3798-MEMO.02 REVISION 2 - FIGURE 1 - THICKENED-EDGE SLAB INSULATION DETAILS AND PLAN


CLIENT  
**HUNTINGTON PROPERTIES**

COPYRIGHT  
 This drawing has been prepared solely for the intended use. Any reproduction or distribution for any purpose other than authorized by IBI Group is forbidden. When dimensions shall have precedence over scaled dimensions. Contractors shall verify and be responsible for all dimensions and conditions on the job, and IBI Group shall be informed of any variations from the dimensions and conditions shown on the drawing. Shop drawings shall be submitted to IBI Group for general conformance before proceeding with fabrication.  
 IBI Group Professional Services (Canada) Inc.  
 is a member of the IBI Group of companies.

ISSUES



| No. | DESCRIPTION               | DATE       |
|-----|---------------------------|------------|
| 1   | ISSUED FOR CITY REVIEW    | 2023-12-09 |
| 2   | REVISED PER CITY COMMENTS | 2023-03-09 |
| 3   | REVISED PER CITY COMMENTS | 2023-06-30 |

SEE 010, 011, 012 FOR NOTES, LEGEND, CB TABLE, STREET SECTIONS AND DETAILS

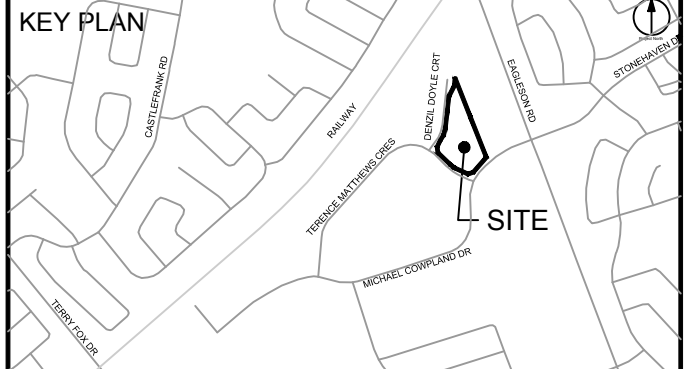

CONSULTANTS

Project Coordinator:  
 Huntington Properties  
 Architect:  
 A49 Architecture  
 Landscape:  
 Fobem  
 Mechanical & Electrical:  
 Goodkey & Woodmark & Associates Limited  
 Surveyor:  
 Annis O'Sullivan Vollebek Ltd.  
 Geotech:  
 Paterson Group

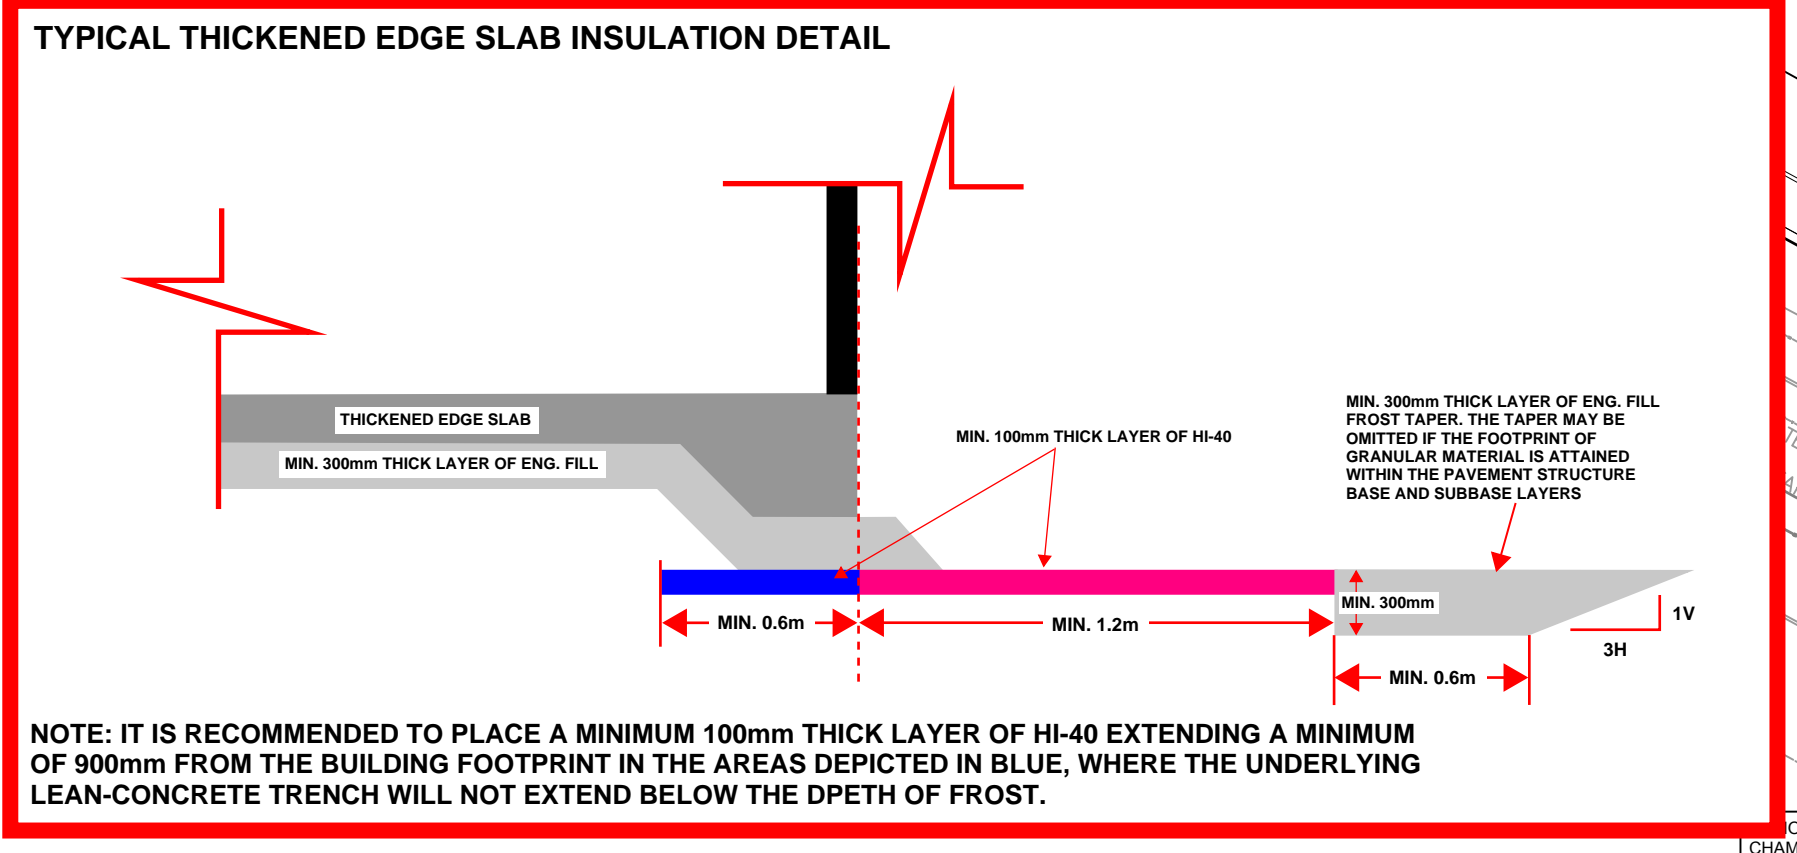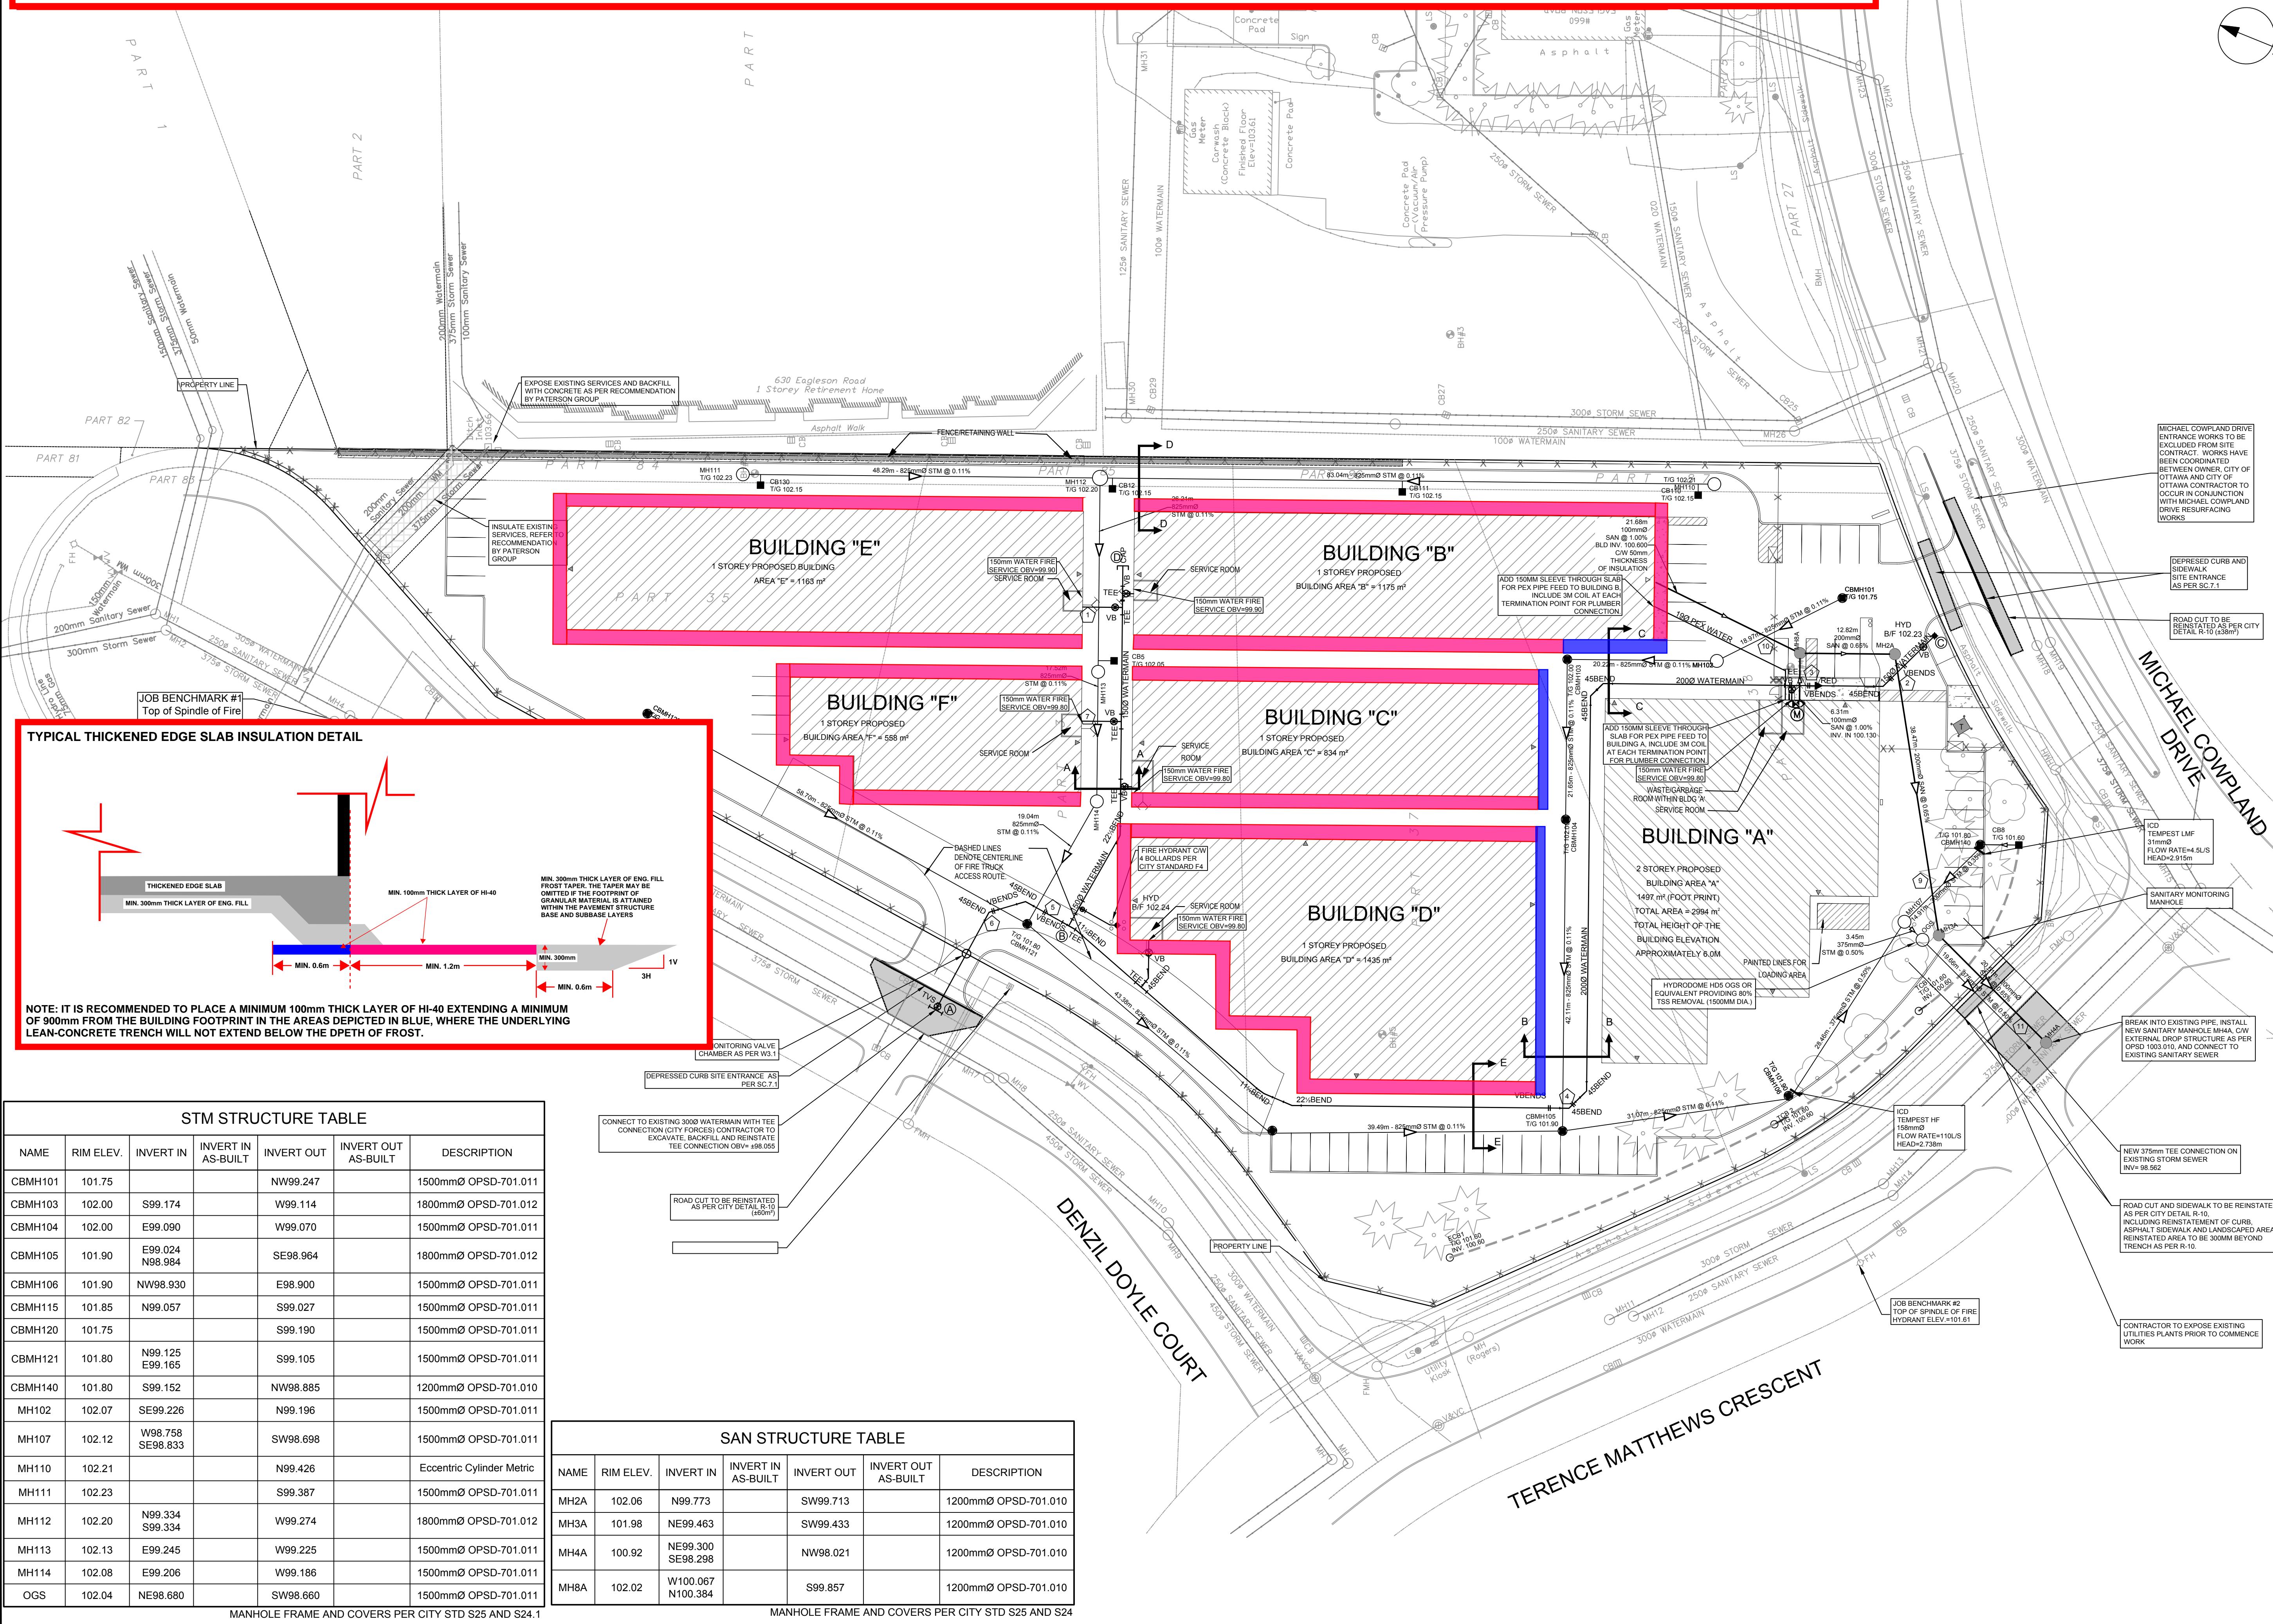

STM STRUCTURE TABLE


| NAME    | RIM ELEV. | INVERT IN           | INVERT IN AS-BUILT | INVERT OUT | INVERT OUT AS-BUILT | DESCRIPTION               |
|---------|-----------|---------------------|--------------------|------------|---------------------|---------------------------|
| CBMH101 | 101.75    |                     |                    | NW99.247   |                     | 1500mmØ OPSD-701.011      |
| CBMH103 | 102.00    | S99.174             |                    | W99.114    |                     | 1800mmØ OPSD-701.012      |
| CBMH104 | 102.00    | E99.090             |                    | W99.070    |                     | 1500mmØ OPSD-701.011      |
| CBMH105 | 101.90    | E99.024<br>N98.984  |                    | SE98.964   |                     | 1800mmØ OPSD-701.012      |
| CBMH106 | 101.90    | NW98.930            |                    | E98.900    |                     | 1500mmØ OPSD-701.011      |
| CBMH115 | 101.85    | N99.057             |                    | S99.027    |                     | 1500mmØ OPSD-701.011      |
| CBMH120 | 101.75    |                     |                    | S99.190    |                     | 1500mmØ OPSD-701.011      |
| CBMH121 | 101.80    | N99.125<br>E99.165  |                    | S99.105    |                     | 1500mmØ OPSD-701.011      |
| CBMH140 | 101.80    | S99.152             |                    | NW98.885   |                     | 1200mmØ OPSD-701.010      |
| MH102   | 102.07    | SE99.226            |                    | N99.196    |                     | 1500mmØ OPSD-701.011      |
| MH107   | 102.12    | W98.758<br>SE98.833 |                    | SW98.698   |                     | 1500mmØ OPSD-701.011      |
| MH110   | 102.21    |                     |                    | N99.426    |                     | Eccentric Cylinder Metric |
| MH111   | 102.23    |                     |                    | S99.387    |                     | 1500mmØ OPSD-701.011      |
| MH112   | 102.20    | N99.334<br>S99.334  |                    | W99.274    |                     | 1800mmØ OPSD-701.012      |
| MH113   | 102.13    | E99.245             |                    | W99.225    |                     | 1500mmØ OPSD-701.011      |
| MH114   | 102.08    | E99.206             |                    | W99.186    |                     | 1500mmØ OPSD-701.011      |
| OGS     | 102.04    | NE98.680            |                    | SW98.680   |                     | 1500mmØ OPSD-701.011      |

MANHOLE FRAME AND COVERS PER CITY STD S25 AND S24.1

SAN STRUCTURE TABLE

| NAME | RIM ELEV. | INVERT IN            | INVERT IN AS-BUILT | INVERT OUT | INVERT OUT AS-BUILT | DESCRIPTION          |
|------|-----------|----------------------|--------------------|------------|---------------------|----------------------|
| MH2A | 102.06    | N99.773              |                    | SW99.713   |                     | 1200mmØ OPSD-701.010 |
| MH3A | 101.98    | NE99.463             |                    | SW99.433   |                     | 1200mmØ OPSD-701.010 |
| MH4A | 100.92    | NE99.300<br>SE98.298 |                    | NW98.021   |                     | 1200mmØ OPSD-701.010 |
| MH8A | 102.02    | W100.067<br>N100.384 |                    | S99.857    |                     | 1200mmØ OPSD-701.010 |

MANHOLE FRAME AND COVERS PER CITY STD S25 AND S24

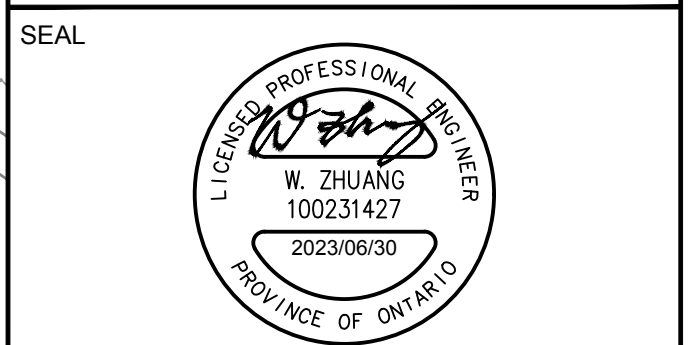

IBI GROUP  
 Suite 400 - 333 Preston Street  
 Ottawa ON K1S 5N4 Canada  
 Tel: 613 225 1311 / 613 241 3300 Fax: 613 225 9868  
 ibigroup.com

PROJECT  
**PROPOSED SELF STORAGE DEVELOPMENT**  
 75 MICHAEL COWPLAND

PROJECT NO:  
 135470  
 DRAWN BY:  
 S.L. / D.D.  
 PROJECT MGR:  
 R.M.  
 SHEET TITLE  
**GENERAL PLAN OF SERVICES**

CHECKED BY:  
 T.R.B.  
 APPROVED BY:  
 T.R.B.  
 SHEET NUMBER  
**C-001**  
 ISSUE  
**3**

CITY PLAN NO. 18885  
 CITY FILE NO. D07-12-22-0174  
 Last Saved: June 29, 2023 10:04:52 AM by Eric Hume  
 Pinned: Thursday, June 29, 2023 10:04:52 AM by Eric Hume