

LEGEND

-  EXTERIOR SITE WORKS
-  EVENT CENTRE & NEW NORTH STANDS

CONSTRUCTION ACCESS AND OPERATIONS
(MARK-UP FROM MEETING 14TH JUNE 2024)

GENERAL NOTES:

- TEMPORARY FIRE ROUTES NEED TO BE LEVEL
- 250 CARS CAN BE PARKED UNDERGROUND @ \$10 DAY/VEHICLE



BRISBROOK BEYON ARCHITECTS
14 DUNCAN ST 4TH FLOOR
TORONTO, ON M5H 3G8
(416) 591-8999

ENTUITIVE
135 LAURIER AVE WEST, SUITE 413
OTTAWA, ON K1P 5J2
(343) 308-9274

TMP
200 KING ST. WEST, SUITE 310
TORONTO, ON M5H 3T4
(416) 499-8000

MULVEY & BANANI
90 SHEPPARD AVE EAST, SUITE 500
TORONTO, ON M2N 3A
(416) 751-2520


S2O
530 N. WOOD STREET #C
CHICAGO, IL 60622
(224) 717-1999

C.S.W.
319 MCRAE AVE (E) SUITE 502
OTTAWA, ONTARIO K1Z 0B9
(613) 738-6336

PRELIMINARY FOR DISCUSSION

DESCRIPTION	DATE
REVISIONS/ ISSUES	

CONTRACTOR SHALL CHECK AND VERIFY ALL DIMENSIONS AND REPORT ANY OMISSIONS OR DISCREPANCIES TO THE ARCHITECT BEFORE PROCEEDING WITH THE WORK. DO NOT SCALE THE DRAWINGS

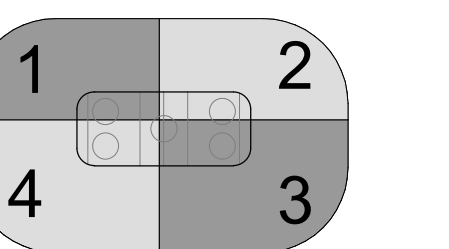

SEAL
THIS DOCUMENT IS RELEASED FOR THE PURPOSE OF PRELIMINARY SUBMITTAL
IT IS NOT TO BE USED FOR CONSTRUCTION PURPOSES

DRAWN: JI
DATE: 01/24/24
CHECKED: SJ

LANSDOWNE EVENT CENTRE


DWG. TITLE
EXTENT OF EVENT CENTRE & NEW NORTH STANDS & EXTERIOR SITE WORKS

SCALE: As indicated
PROJ. NO.: 2008
DWG. NO.: A1-008f

DATE PLOTTED: 2024-06-12 11:17:51 AM

EXTENT OF EVENT CENTRE & NEW NORTH STANDS & EXTERIOR SITE WORKS

1:1000

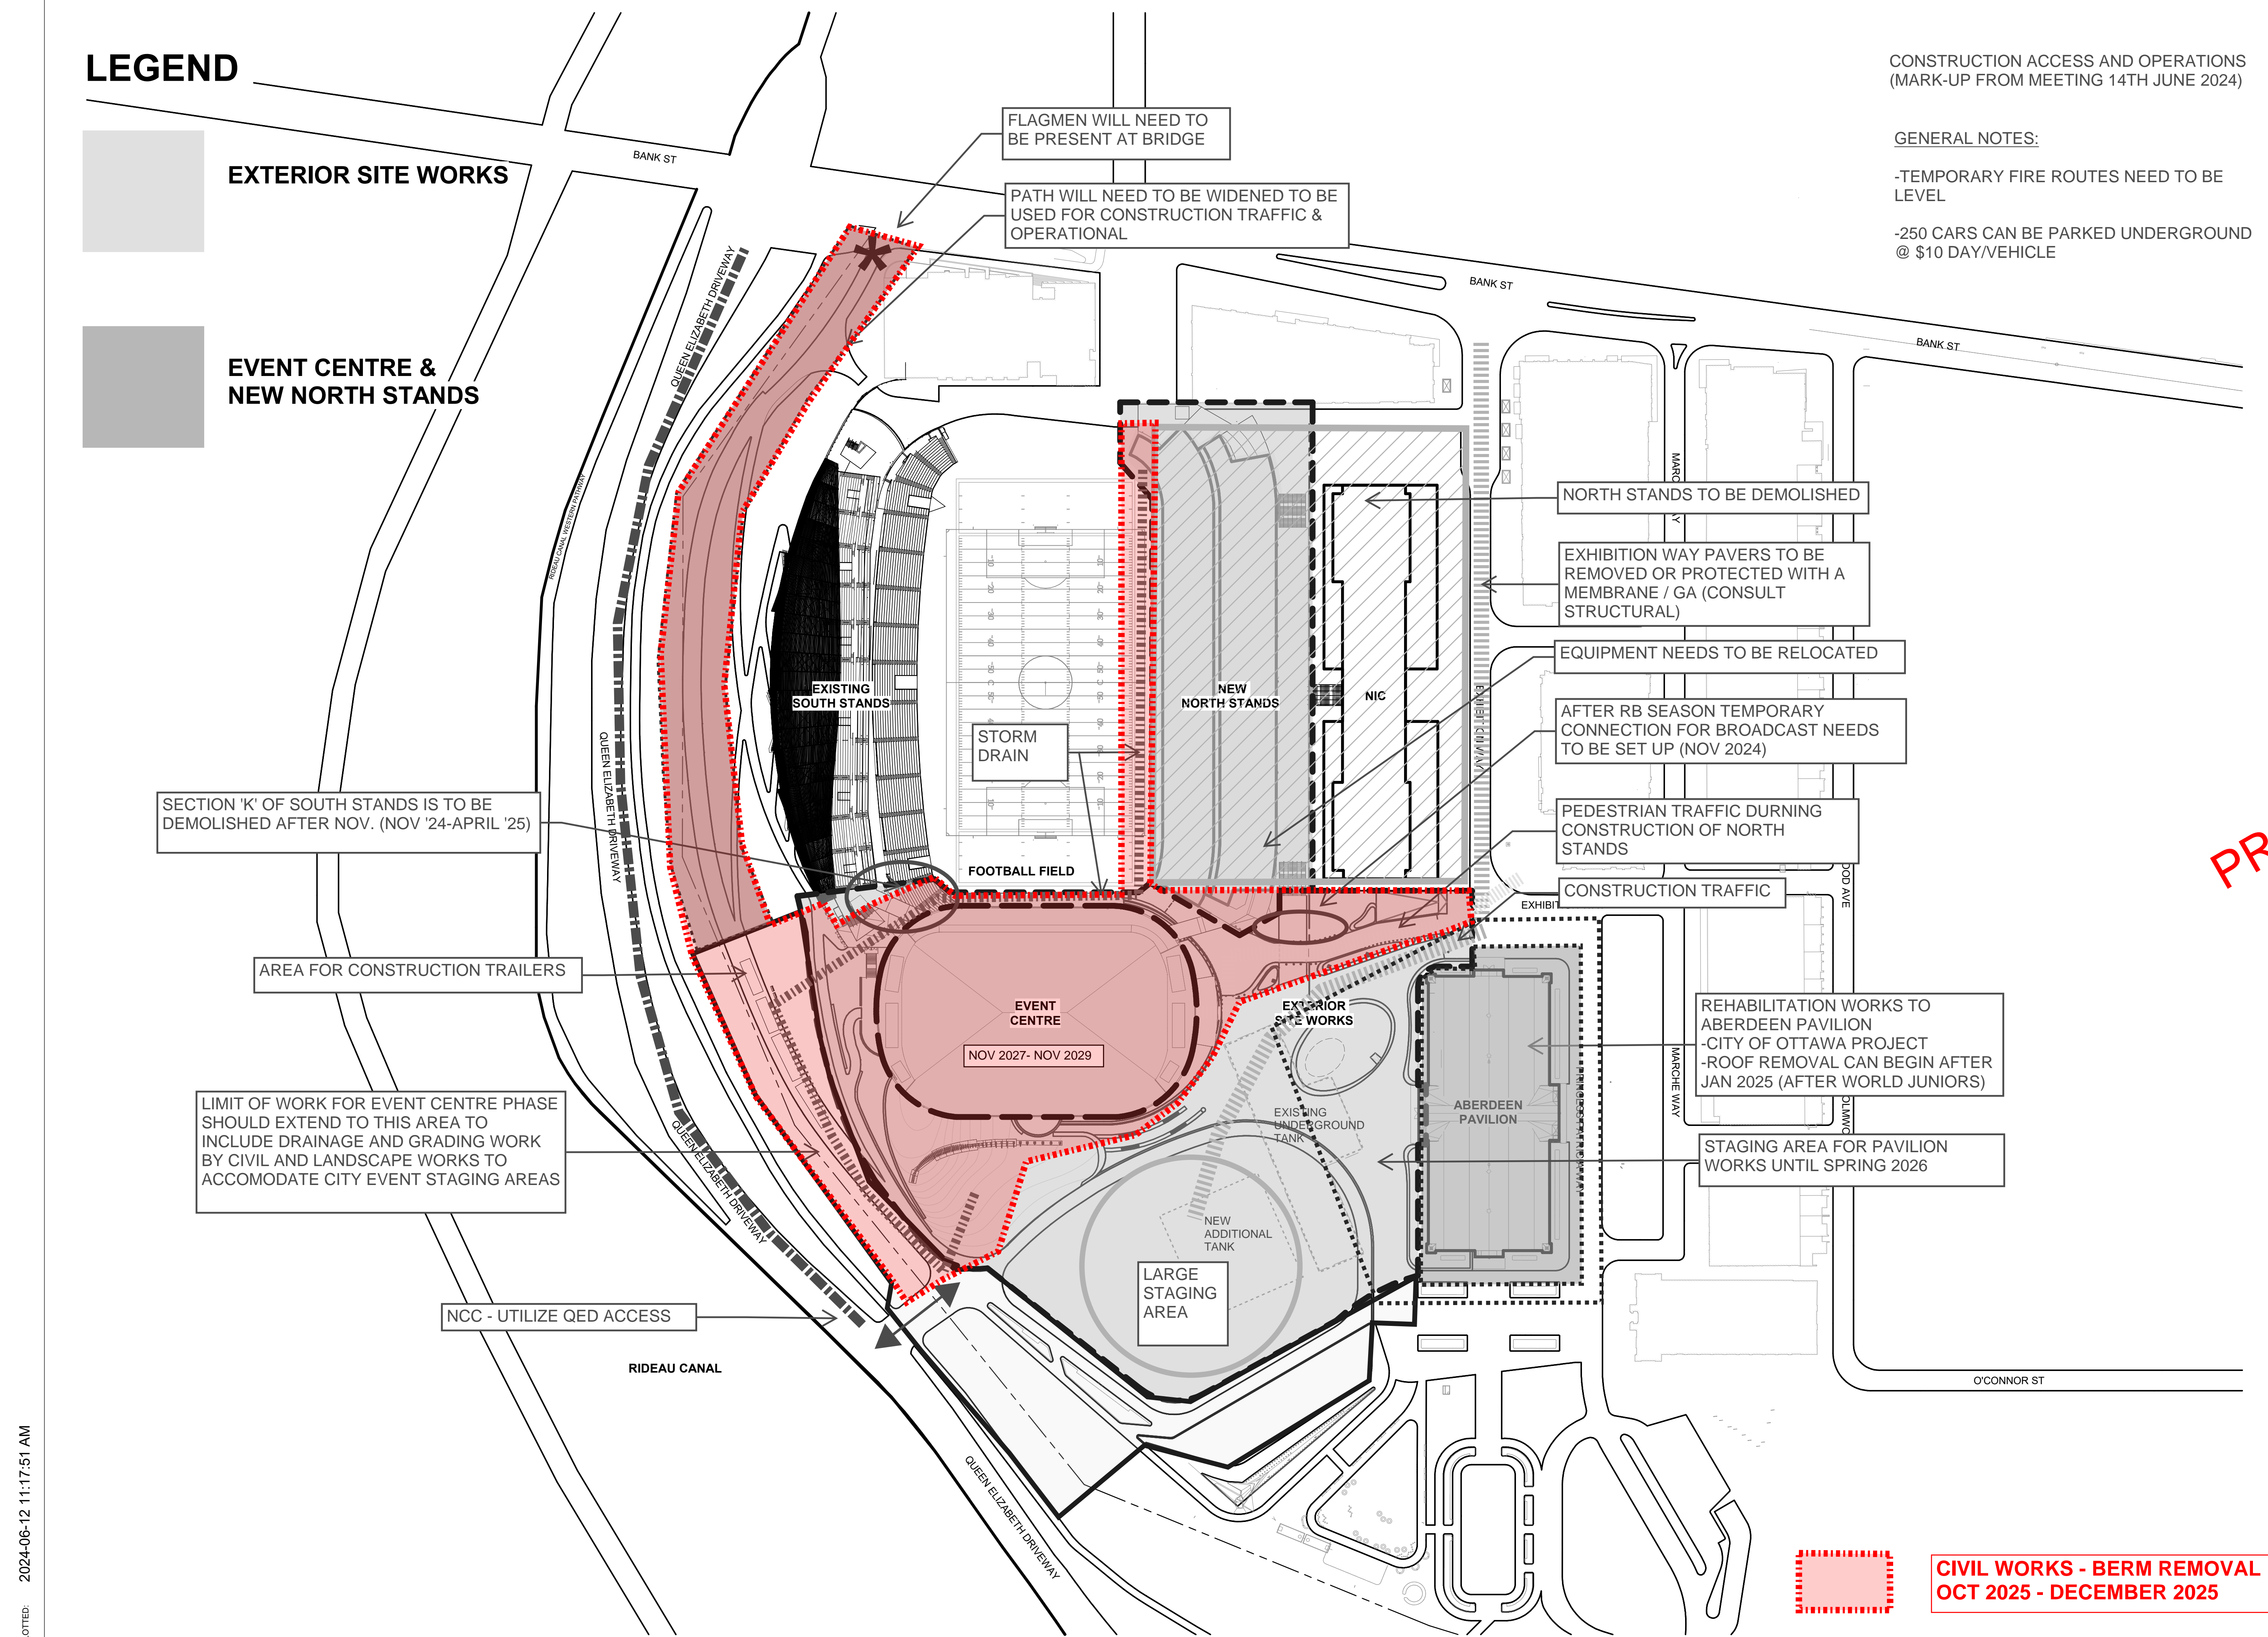

**CIVIL WORKS - BERM REMOVAL
OCT 2025 - DECEMBER 2025**

LEGEND

-  EXTERIOR SITE WORKS
-  EVENT CENTRE & NEW NORTH STANDS

CONSTRUCTION ACCESS AND OPERATIONS
(MARK-UP FROM MEETING 14TH JUNE 2024)

GENERAL NOTES:

- TEMPORARY FIRE ROUTES NEED TO BE LEVEL
- 250 CARS CAN BE PARKED UNDERGROUND @ \$10 DAY/VEHICLE



BRISBIN BROOK BEYON ARCHITECTS
14 DUNCAN ST 4TH FLOOR
TORONTO, ON M5H 3G8
(416) 591-8999

ENTUITIVE
135 LAURIER AVE WEST, SUITE 413
OTTAWA, ON K1P 5J2
(343) 308-9274

TMP
200 KING ST. WEST, SUITE 310
TORONTO, ON M5H 3T4
(416) 499-8000

MULVEY & BANANI
90 SHEPPARD AVE EAST, SUITE 500
TORONTO, ON M2N 3A
(416) 751-2520


S2O
530 N. WOOD STREET #C
CHICAGO, IL 60622
(224) 717-1999

C.S.W.
319 MCRAE AVENUE, SUITE 502
OTTAWA, ONTARIO K1Z 0B9
(613) 729-4536

PRELIMINARY FOR DISCUSSION

NO.	DATE	REVISIONS/ ISSUES

CONTRACTOR SHALL CHECK AND VERIFY ALL DIMENSIONS AND REPORT ANY OMISSIONS OR DISCREPANCIES TO THE ARCHITECT BEFORE PROCEEDING WITH THE WORK. DO NOT SCALE THE DRAWINGS

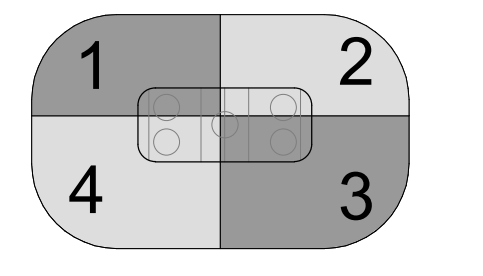


SEAL
THIS DOCUMENT IS RELEASED FOR THE PURPOSE OF PRELIMINARY SUBMITTAL
IT IS NOT TO BE USED FOR CONSTRUCTION PURPOSES

DRAWN	JJ
DATE	01/24/24
CHECKED	SJ

LANSDOWNE EVENT CENTRE

DWG. TITLE
EXTENT OF EVENT CENTRE & NEW NORTH STANDS & EXTERIOR SITE WORKS

SCALE	As indicated	DWG. NO.	A1-008f
PROJ. NO.	2008		

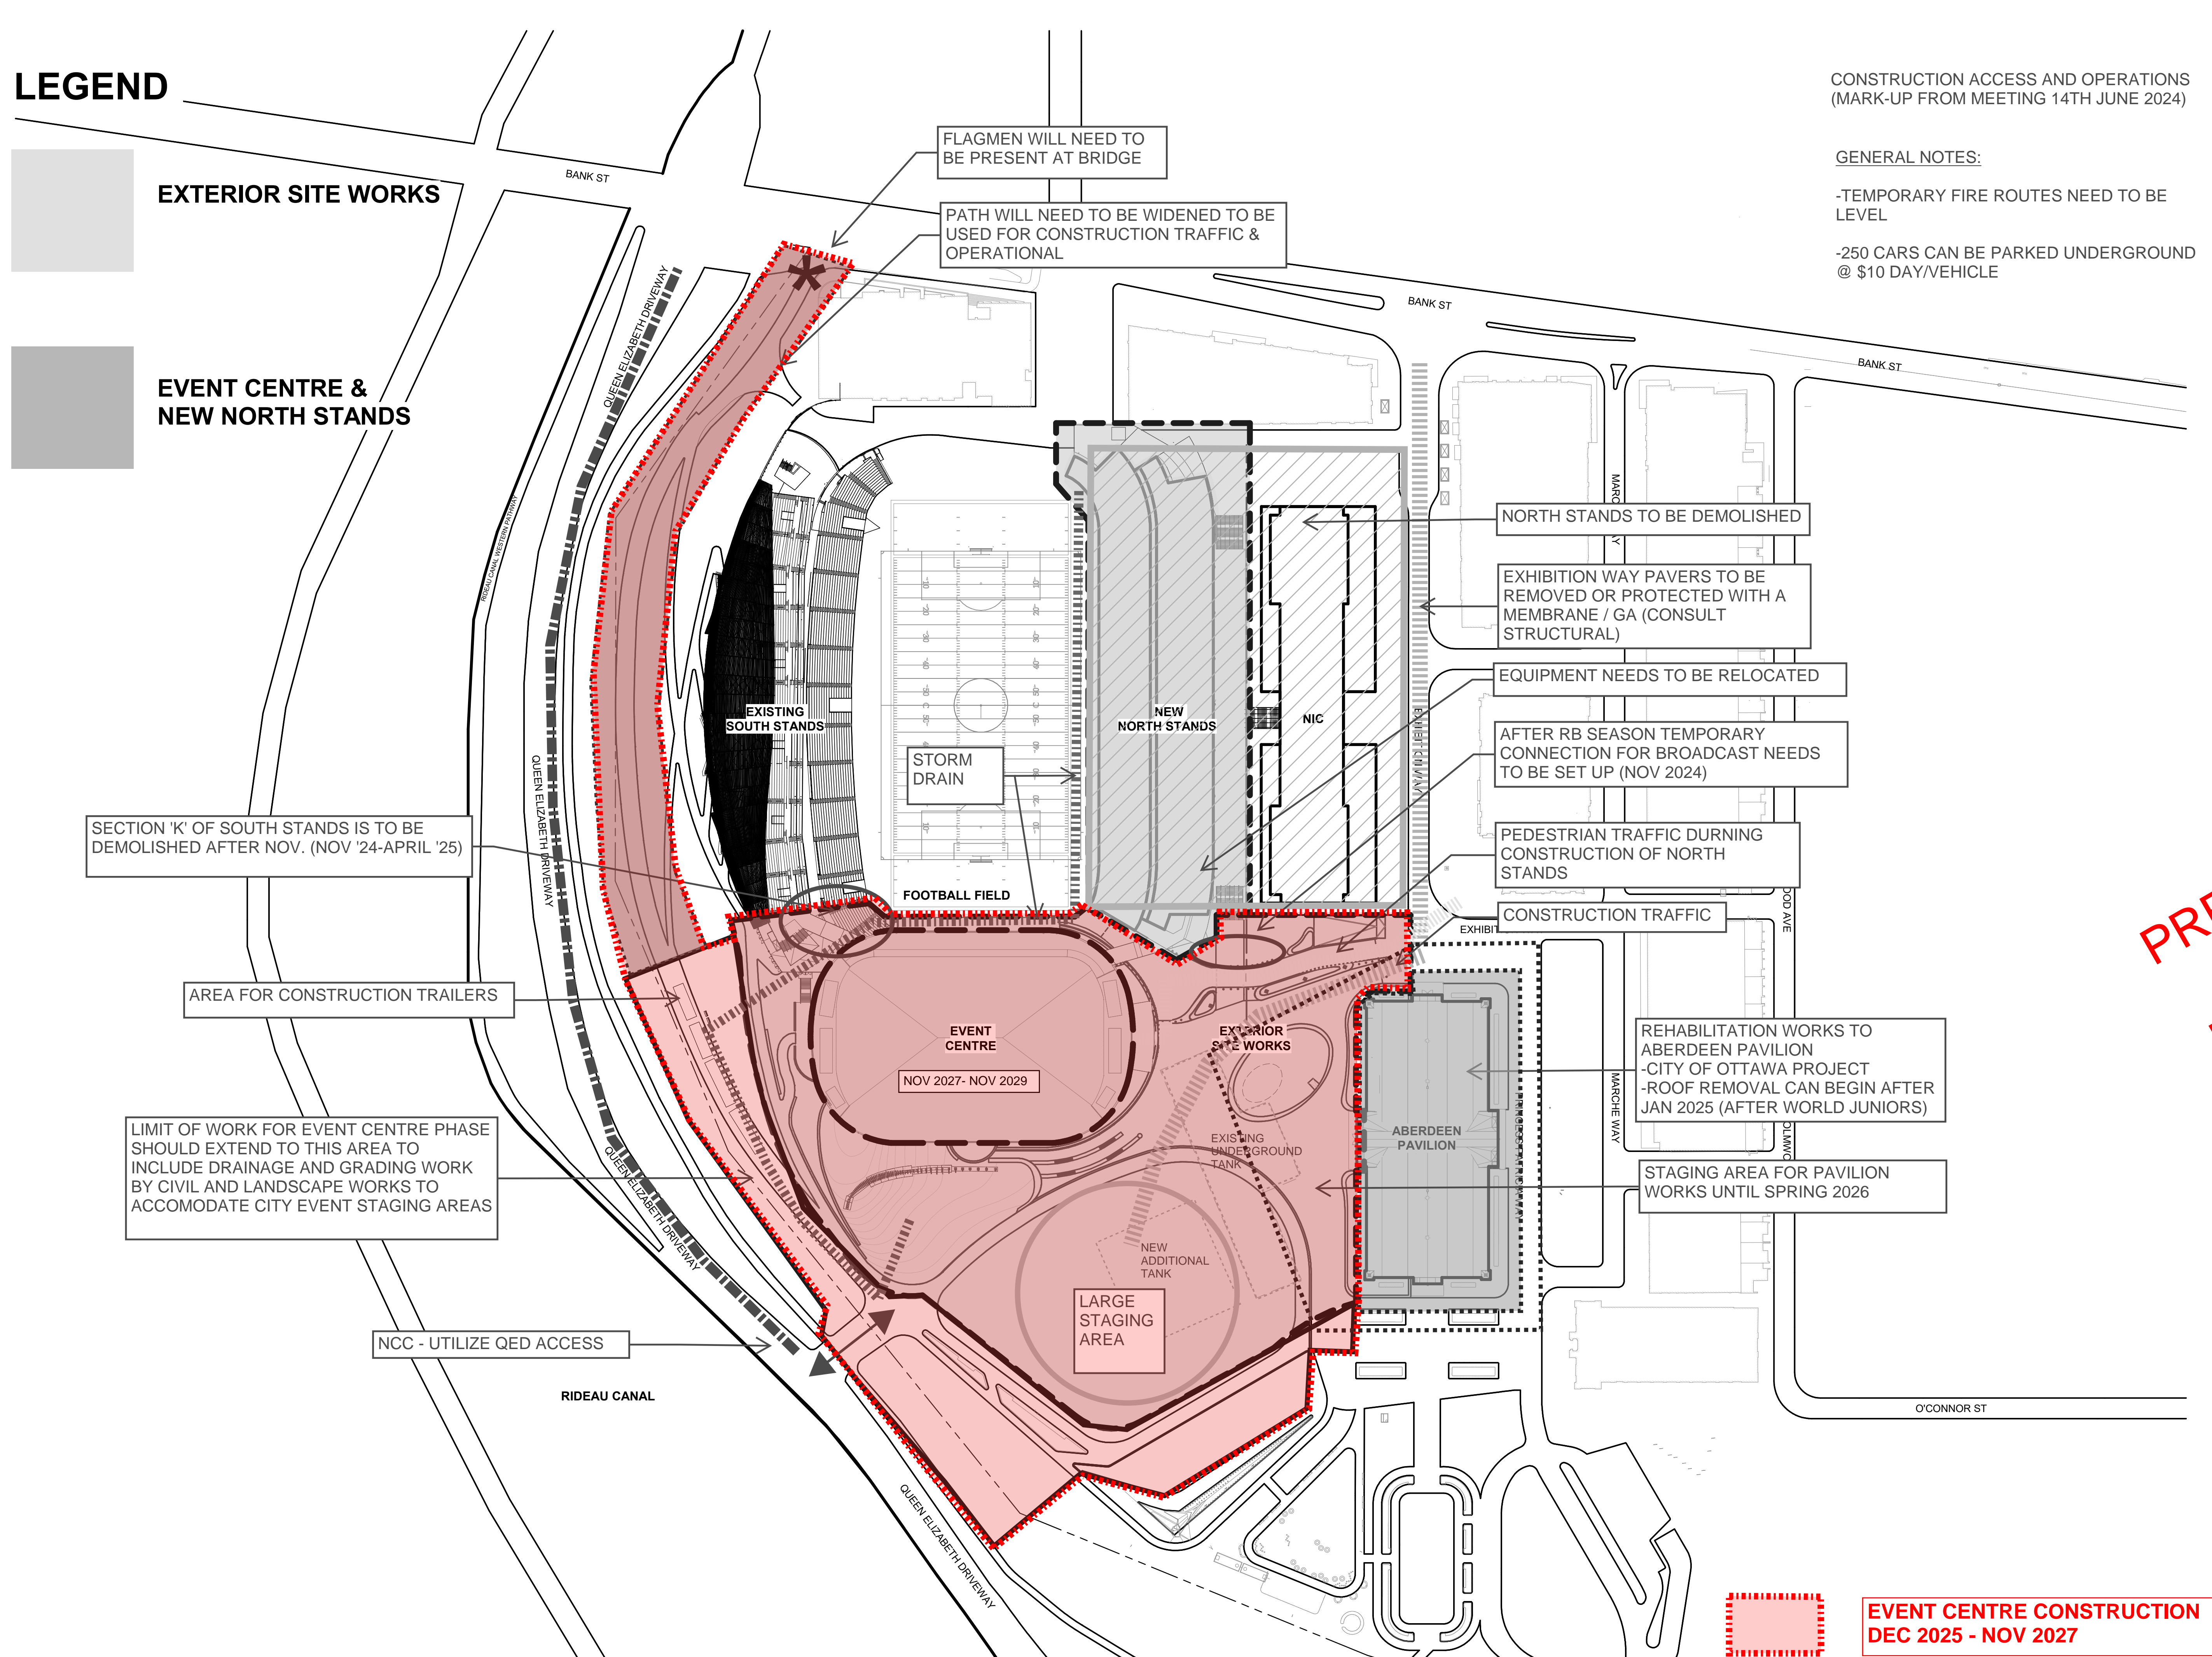

FLAGMEN WILL NEED TO BE PRESENT AT BRIDGE

PATH WILL NEED TO BE WIDENED TO BE USED FOR CONSTRUCTION TRAFFIC & OPERATIONAL

NORTH STANDS TO BE DEMOLISHED

EXHIBITION WAY PAVERS TO BE REMOVED OR PROTECTED WITH A MEMBRANE / GA (CONSULT STRUCTURAL)

EQUIPMENT NEEDS TO BE RELOCATED

AFTER RB SEASON TEMPORARY CONNECTION FOR BROADCAST NEEDS TO BE SET UP (NOV 2024)

PEDESTRIAN TRAFFIC DURING CONSTRUCTION OF NORTH STANDS

CONSTRUCTION TRAFFIC

REHABILITATION WORKS TO ABERDEEN PAVILION -CITY OF OTTAWA PROJECT -ROOF REMOVAL CAN BEGIN AFTER JAN 2025 (AFTER WORLD JUNIORS)

STAGING AREA FOR PAVILION WORKS UNTIL SPRING 2026

SECTION 'K' OF SOUTH STANDS IS TO BE DEMOLISHED AFTER NOV. (NOV '24-APRIL '25)

AREA FOR CONSTRUCTION TRAILERS

LIMIT OF WORK FOR EVENT CENTRE PHASE SHOULD EXTEND TO THIS AREA TO INCLUDE DRAINAGE AND GRADING WORK BY CIVIL AND LANDSCAPE WORKS TO ACCOMMODATE CITY EVENT STAGING AREAS

NCC - UTILIZE QED ACCESS

STORM DRAIN

FOOTBALL FIELD

EVENT CENTRE
NOV 2027- NOV 2029

EXTERIOR SITE WORKS

EXISTING UNDERGROUND TANK

NEW ADDITIONAL TANK

LARGE STAGING AREA

NIC

ABERDEEN PAVILION

EVENT CENTRE CONSTRUCTION
DEC 2025 - NOV 2027

LEGEND

-  EXTERIOR SITE WORKS
-  EVENT CENTRE & NEW NORTH STANDS

CONSTRUCTION ACCESS AND OPERATIONS
(MARK-UP FROM MEETING 14TH JUNE 2024)

GENERAL NOTES:

- TEMPORARY FIRE ROUTES NEED TO BE LEVEL
- 250 CARS CAN BE PARKED UNDERGROUND @ \$10 DAY/VEHICLE



BRISBIN BROOK BEYOND ARCHITECTS
14 DUNCAN ST 4TH FLOOR
TORONTO, ON M5H 3G8
(416) 591-8999

ENTUITIVE
135 LAURIER AVE WEST, SUITE 413
OTTAWA, ON K1P 5J2
(343) 308-9274

TMP
200 KING ST. WEST, SUITE 310
TORONTO, ON M5H 3T4
(416) 499-8000


MULVEY & BANANI
90 SHEPPARD AVE EAST, SUITE 500
TORONTO, ON M2N 3A
(416) 751-2520

S2O
530 N. WOOD STREET #C
CHICAGO, IL 60622
(224) 717-1999

C.S.W.
319 MCRAE AVENUE, SUITE 502
OTTAWA, ONTARIO K1Z 0B9
(613) 729-4536

PRELIMINARY FOR DISCUSSION

NO.	DESCRIPTION	DATE
REVISIONS/ ISSUES		
CONFIRMATION: SHALL CHECK AND VERIFY ALL DIMENSIONS AND NOTATIONS FOR ANY OMISSIONS OR DISCREPANCIES TO THE ARCHITECT BEFORE PROCEEDING WITH THE WORK. DO NOT SCALE THE DRAWINGS.		

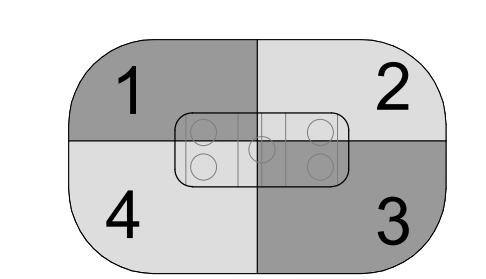

SEAL

THIS DOCUMENT IS RELEASED FOR THE PURPOSE OF PRELIMINARY SUBMITTAL

IT IS NOT TO BE USED FOR CONSTRUCTION PURPOSES


DRAWN	JJ
DATE	01/24/24
CHECKED	SJ



LANSDOWNE EVENT CENTRE

DWG. TITLE
EXTENT OF EVENT CENTRE & NEW NORTH STANDS & EXTERIOR SITE WORKS

SCALE	As indicated	DWG. NO.	A1-008f
PROJ. NO.	2008		

DATE PLOTTED: 2024-06-12 11:17:51 AM

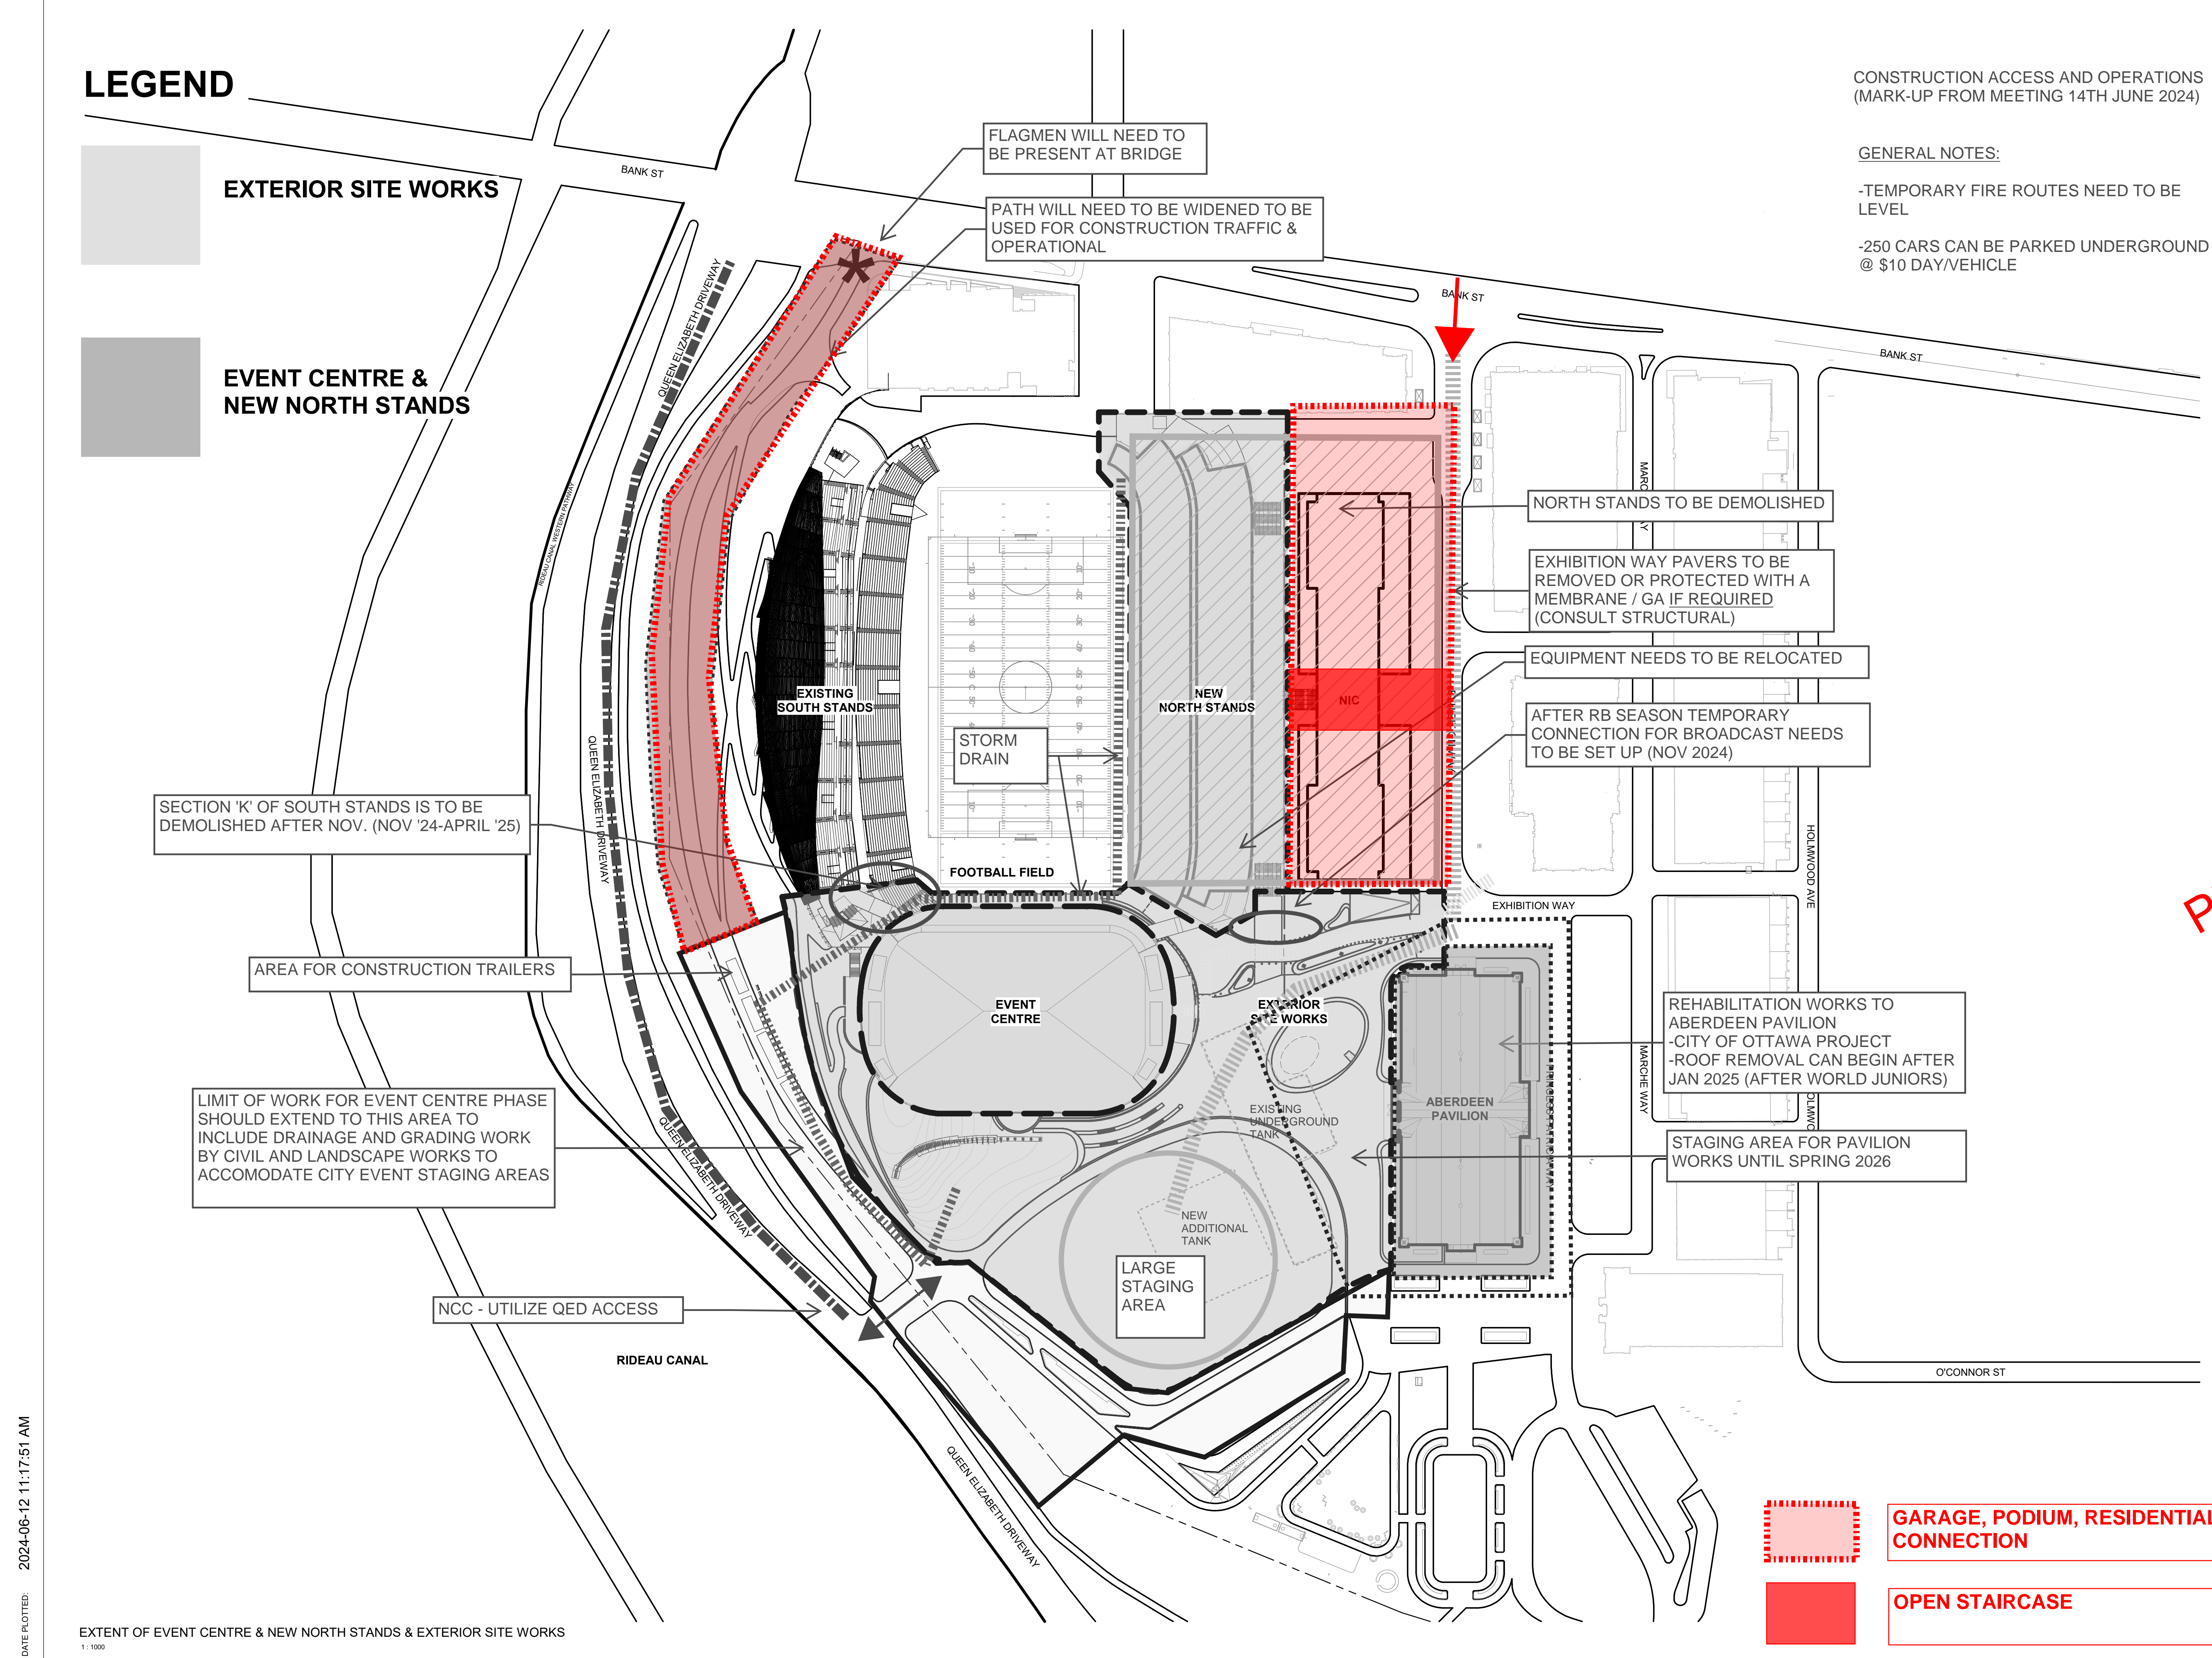

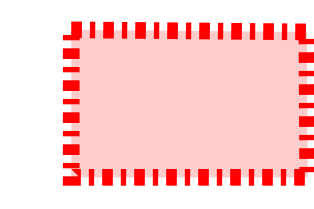-  GARAGE, PODIUM, RESIDENTIAL CONNECTION
-  OPEN STAIRCASE

LEGEND

-  EXTERIOR SITE WORKS
-  EVENT CENTRE & NEW NORTH STANDS

CONSTRUCTION ACCESS AND OPERATIONS
(MARK-UP FROM MEETING 14TH JUNE 2024)

GENERAL NOTES:

- TEMPORARY FIRE ROUTES NEED TO BE LEVEL
- 250 CARS CAN BE PARKED UNDERGROUND @ \$10 DAY/VEHICLE




Ottawa Sports and Entertainment Group

BRISBIN BROOK BEYON ARCHITECTS
14 DUNCAN ST 4TH FLOOR
TORONTO, ON M5H 3G8
(416) 591-8999

ENTUITIVE
135 LAURIER AVE WEST, SUITE 413
OTTAWA, ON K1P 5J2
(343) 308-9274


TMP
200 KING ST. WEST, SUITE 310
TORONTO, ON M5H 3T4
(416) 499-8000

MULVEY & BANANI
90 SHEPPARD AVE EAST, SUITE 500
TORONTO, ON M2N 3A
(416) 751-2520

S2O
530 N. WOOD STREET #C
CHICAGO, IL 60622
(224) 717-1999

C.S.W.
319 MCRAE AVENUE, SUITE 502
OTTAWA, ONTARIO K1Z 0B9
(613) 729-4536

PRELIMINARY FOR DISCUSSION

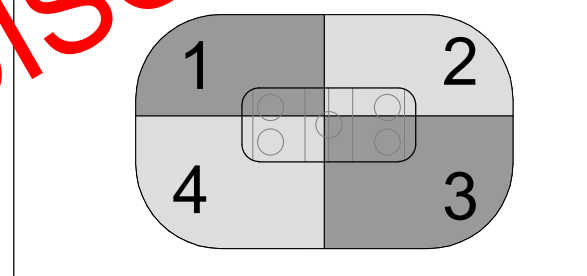


SEAL
THIS DOCUMENT IS RELEASED FOR THE PURPOSE OF PRELIMINARY SUBMITTAL
IT IS NOT TO BE USED FOR CONSTRUCTION PURPOSES

DRAWN	JJ
DATE	01/24/24
CHECKED	SJ

LANSDOWNE EVENT CENTRE

DWG. TITLE
EXTENT OF EVENT CENTRE & NEW NORTH STANDS & EXTERIOR SITE WORKS

SCALE	As indicated	DWG. NO.	A1-008f
PROJ. NO.	2008		

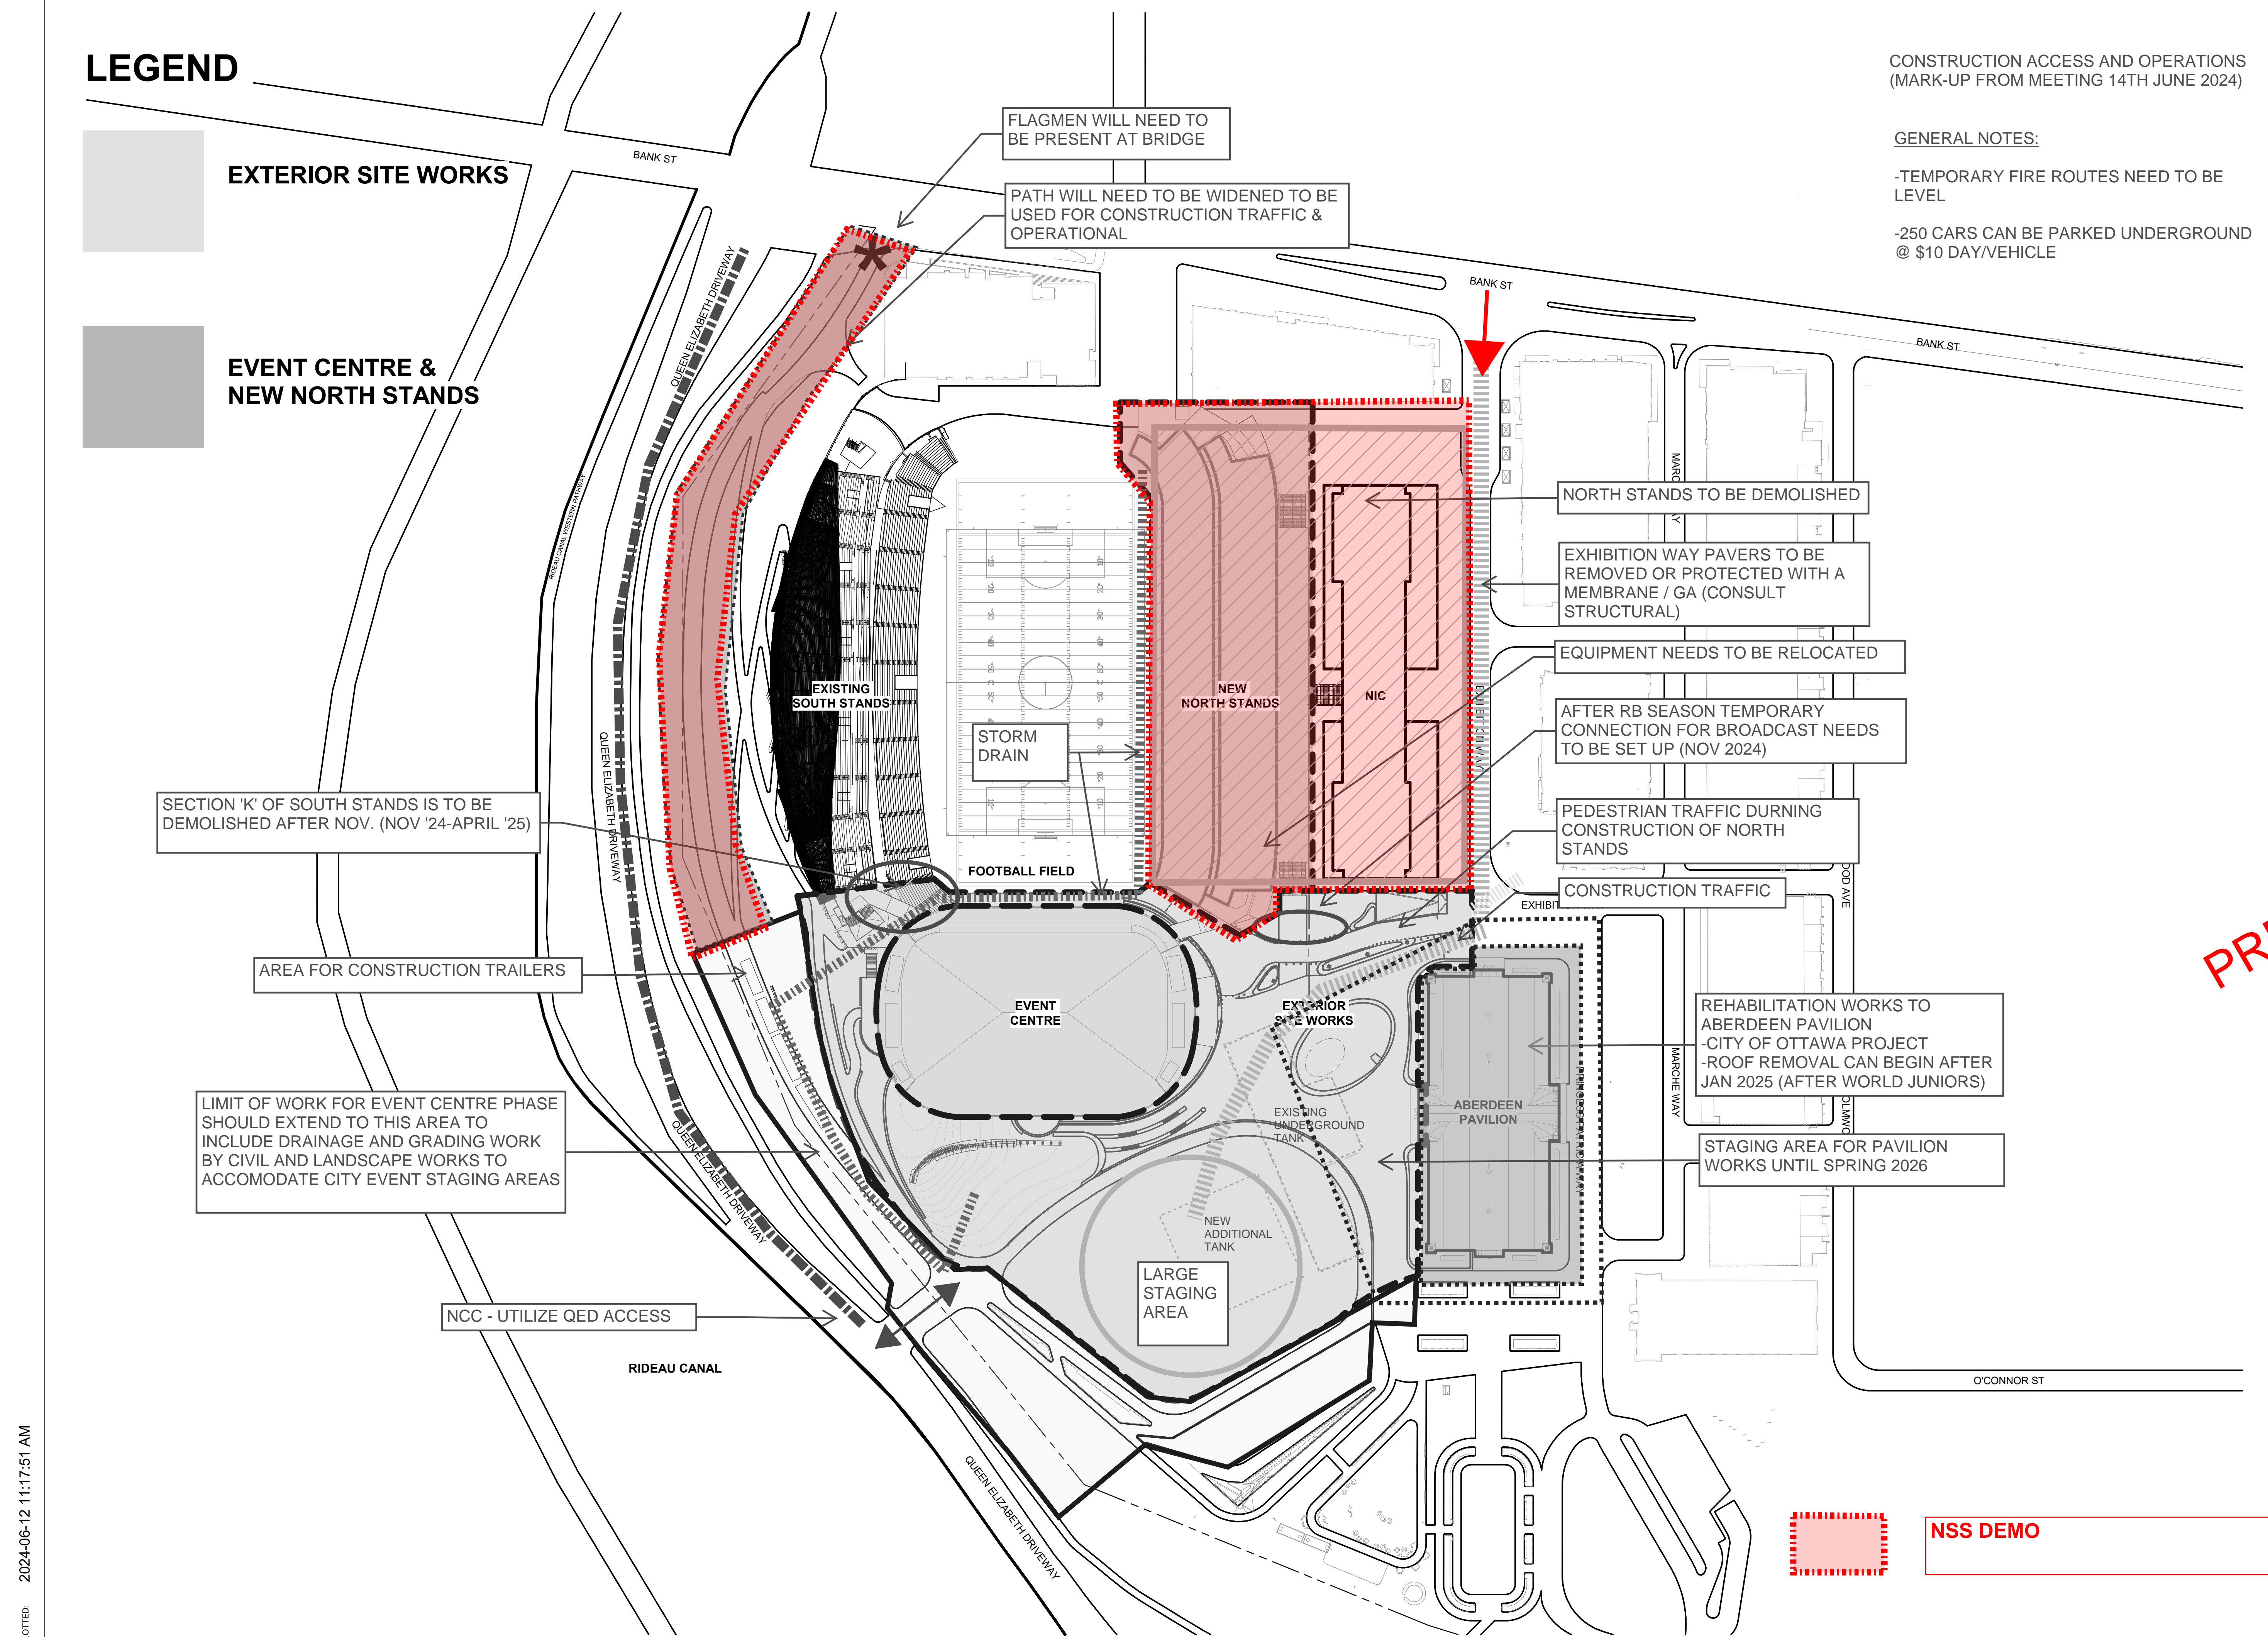

DATE PLOTTED: 2024-06-12 11:17:51 AM

LEGEND

- EXTERIOR SITE WORKS
- EVENT CENTRE & NEW NORTH STANDS

CONSTRUCTION ACCESS AND OPERATIONS (MARK-UP FROM MEETING 14TH JUNE 2024)

GENERAL NOTES:
 -TEMPORARY FIRE ROUTES NEED TO BE LEVEL
 -250 CARS CAN BE PARKED UNDERGROUND @ \$10 DAY/VEHICLE



BRISBIN BROOK BEYON ARCHITECTS
 14 DUNCAN ST 4TH FLOOR
 TORONTO, ON M5H 3G8
 (416) 591-8999

ENTUITIVE
 135 LAURIER AVE WEST, SUITE 413
 OTTAWA, ON K1P 5J2
 (343) 308-9274

TMP
 200 KING ST. WEST, SUITE 310
 TORONTO, ON M5H 3T4
 (416) 499-8000

MULVEY & BANANI
 90 SHEPPARD AVE EAST, SUITE 500
 TORONTO, ON M2N 3A
 (416) 751-2520


S2O
 530 N. WOOD STREET #C
 CHICAGO, IL 60622
 (224) 717-1999

C.S.W.
 319 MCRAE AVENUE, SUITE 502
 OTTAWA, ON K1Z 0B9
 (613) 226-6633

PRELIMINARY FOR DISCUSSION

NO.	DESCRIPTION	DATE
	REVISIONS/ ISSUES	

CONTRACTOR SHALL CHECK AND VERIFY ALL DIMENSIONS AND REPORT ANY OMISSIONS OR DISCREPANCIES TO THE ARCHITECT BEFORE PROCEEDING WITH THE WORK. DO NOT SCALE THE DRAWINGS

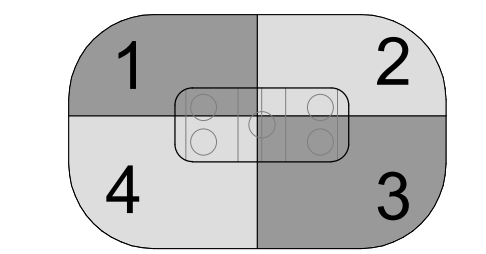


SEAL
 THIS DOCUMENT IS RELEASED FOR THE PURPOSE OF PRELIMINARY SUBMITTAL
 IT IS NOT TO BE USED FOR CONSTRUCTION PURPOSES

DRAWN: JI
 DATE: 01/24/24
 CHECKED: SJ

LANSDOWNE EVENT CENTRE

DWG. TITLE: EXTENT OF EVENT CENTRE & NEW NORTH STANDS & EXTERIOR SITE WORKS

SCALE: As indicated DWG. NO.: A1-008f
 PROJ. NO.: 2008

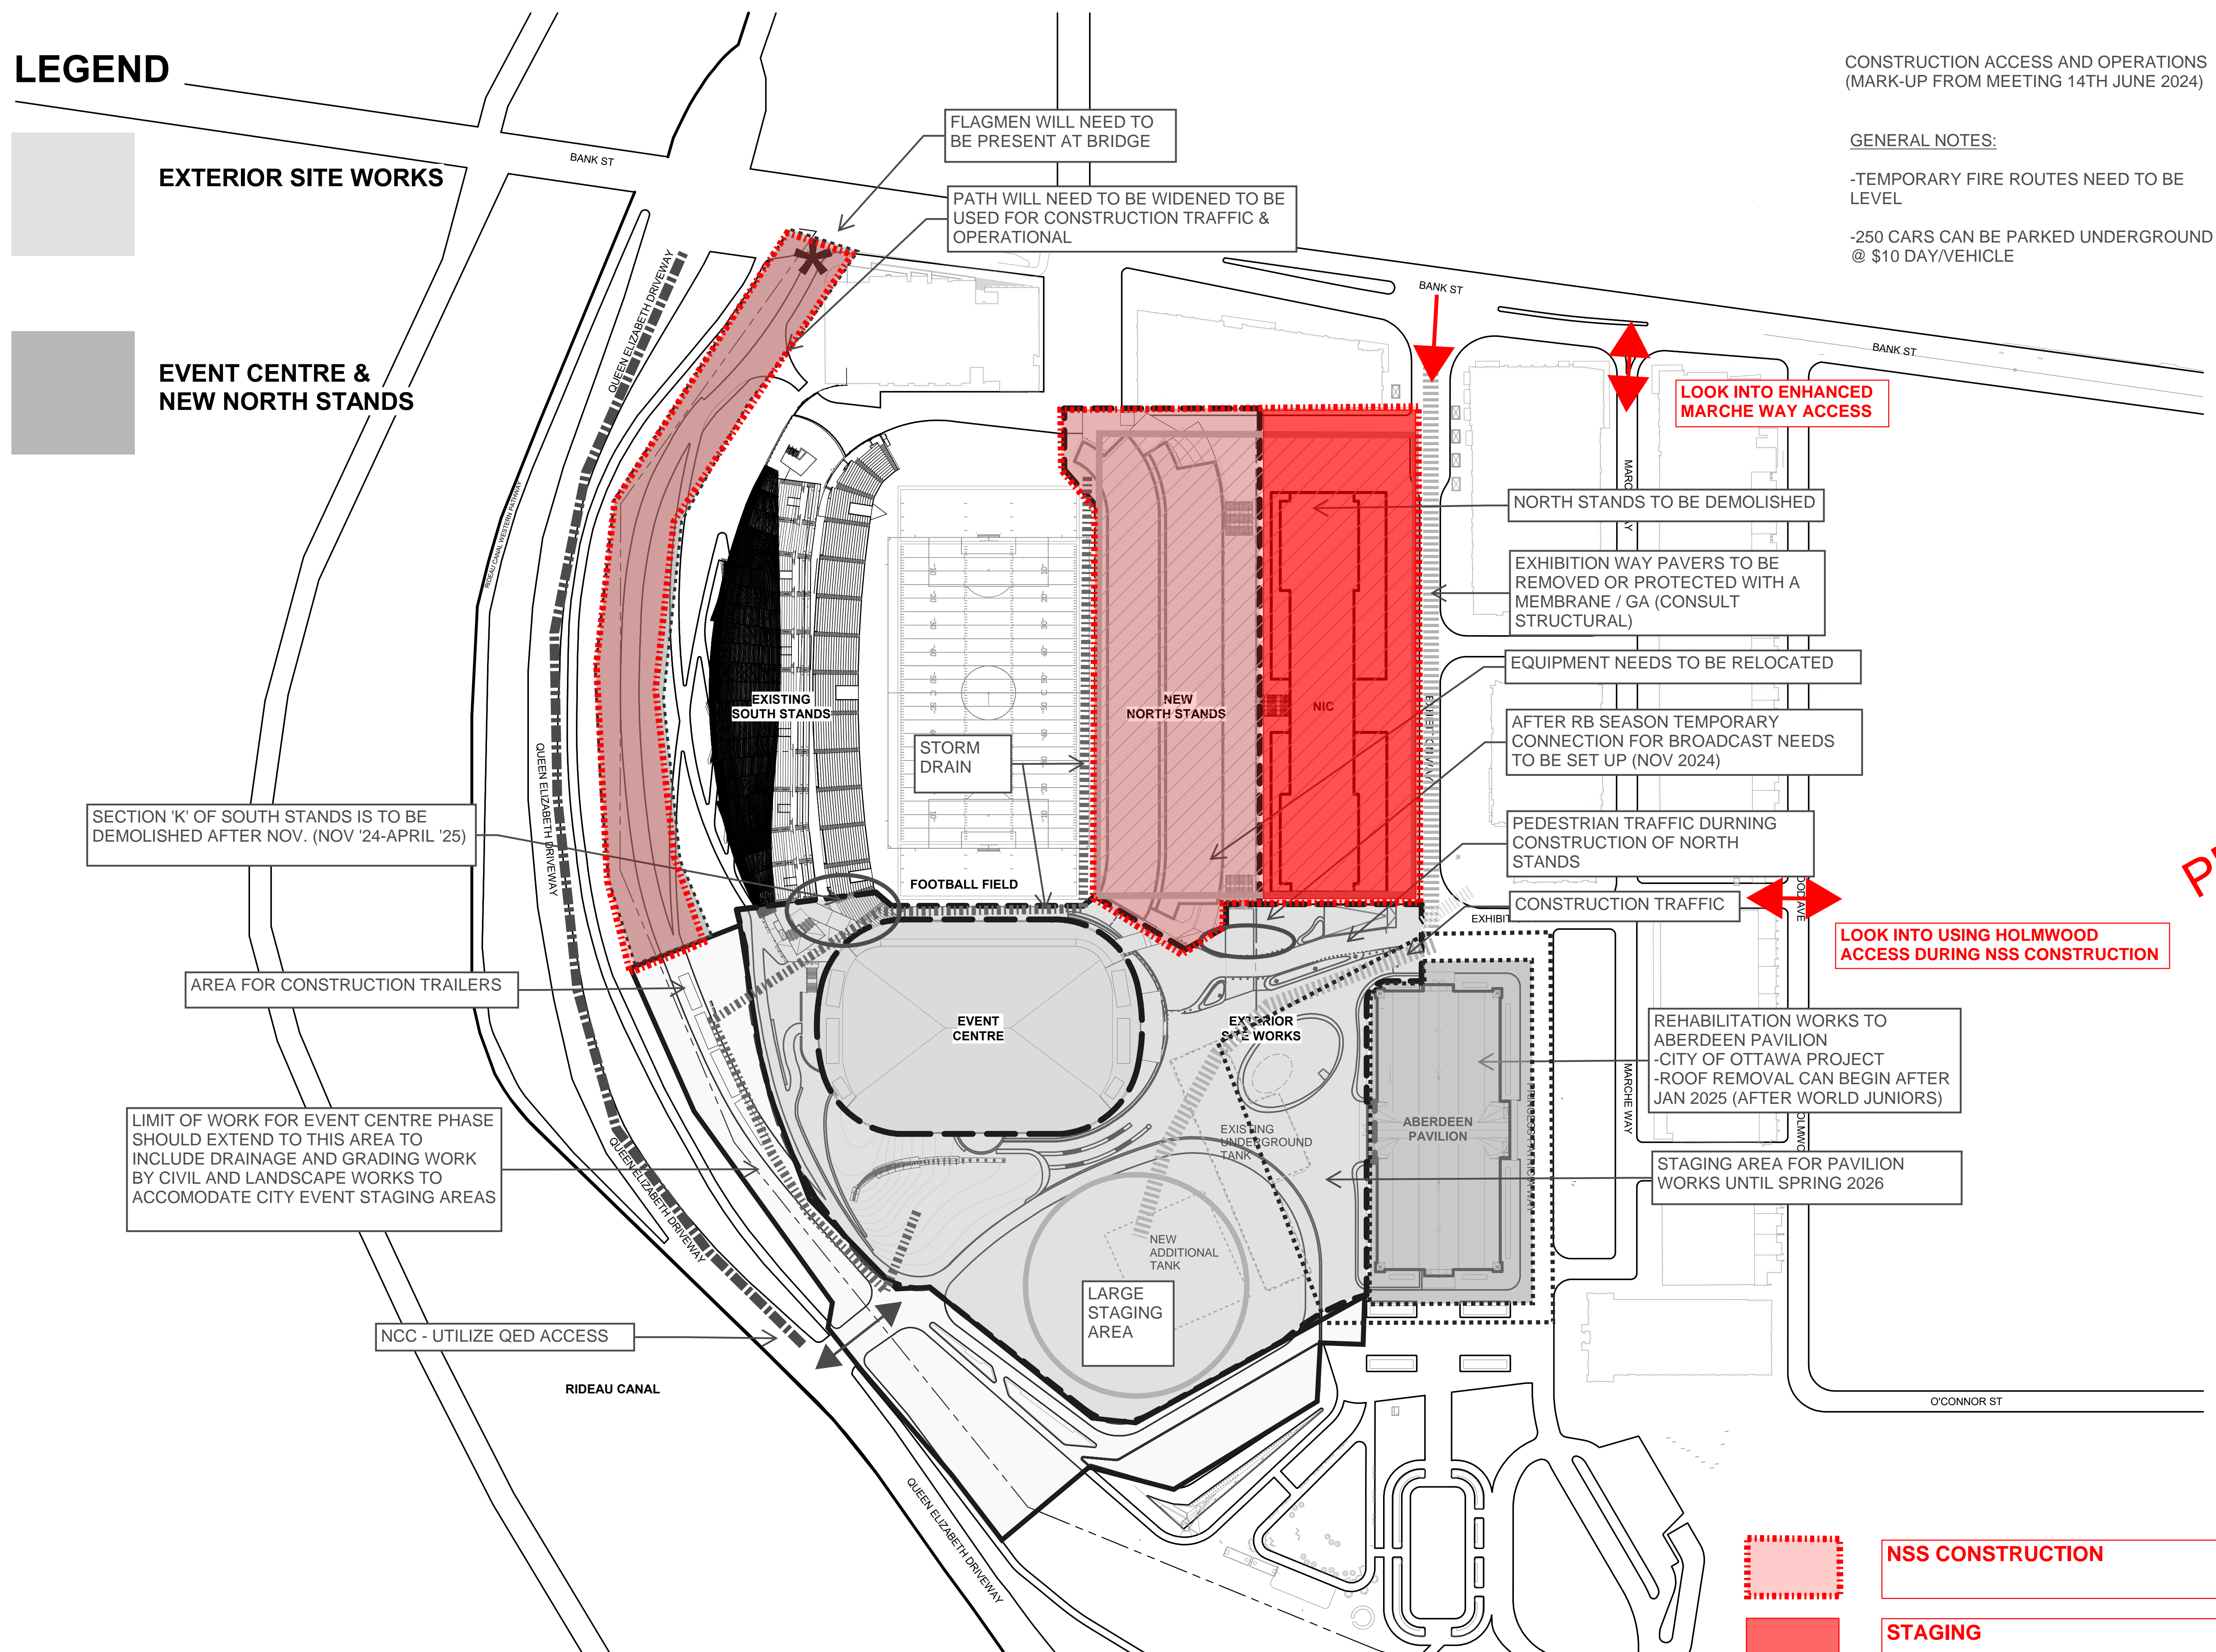

- NSS CONSTRUCTION
- STAGING