
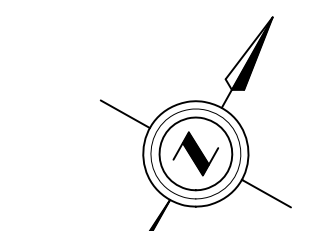


FLAGSTAFF DRIVE

BORROSİKANE ROAD

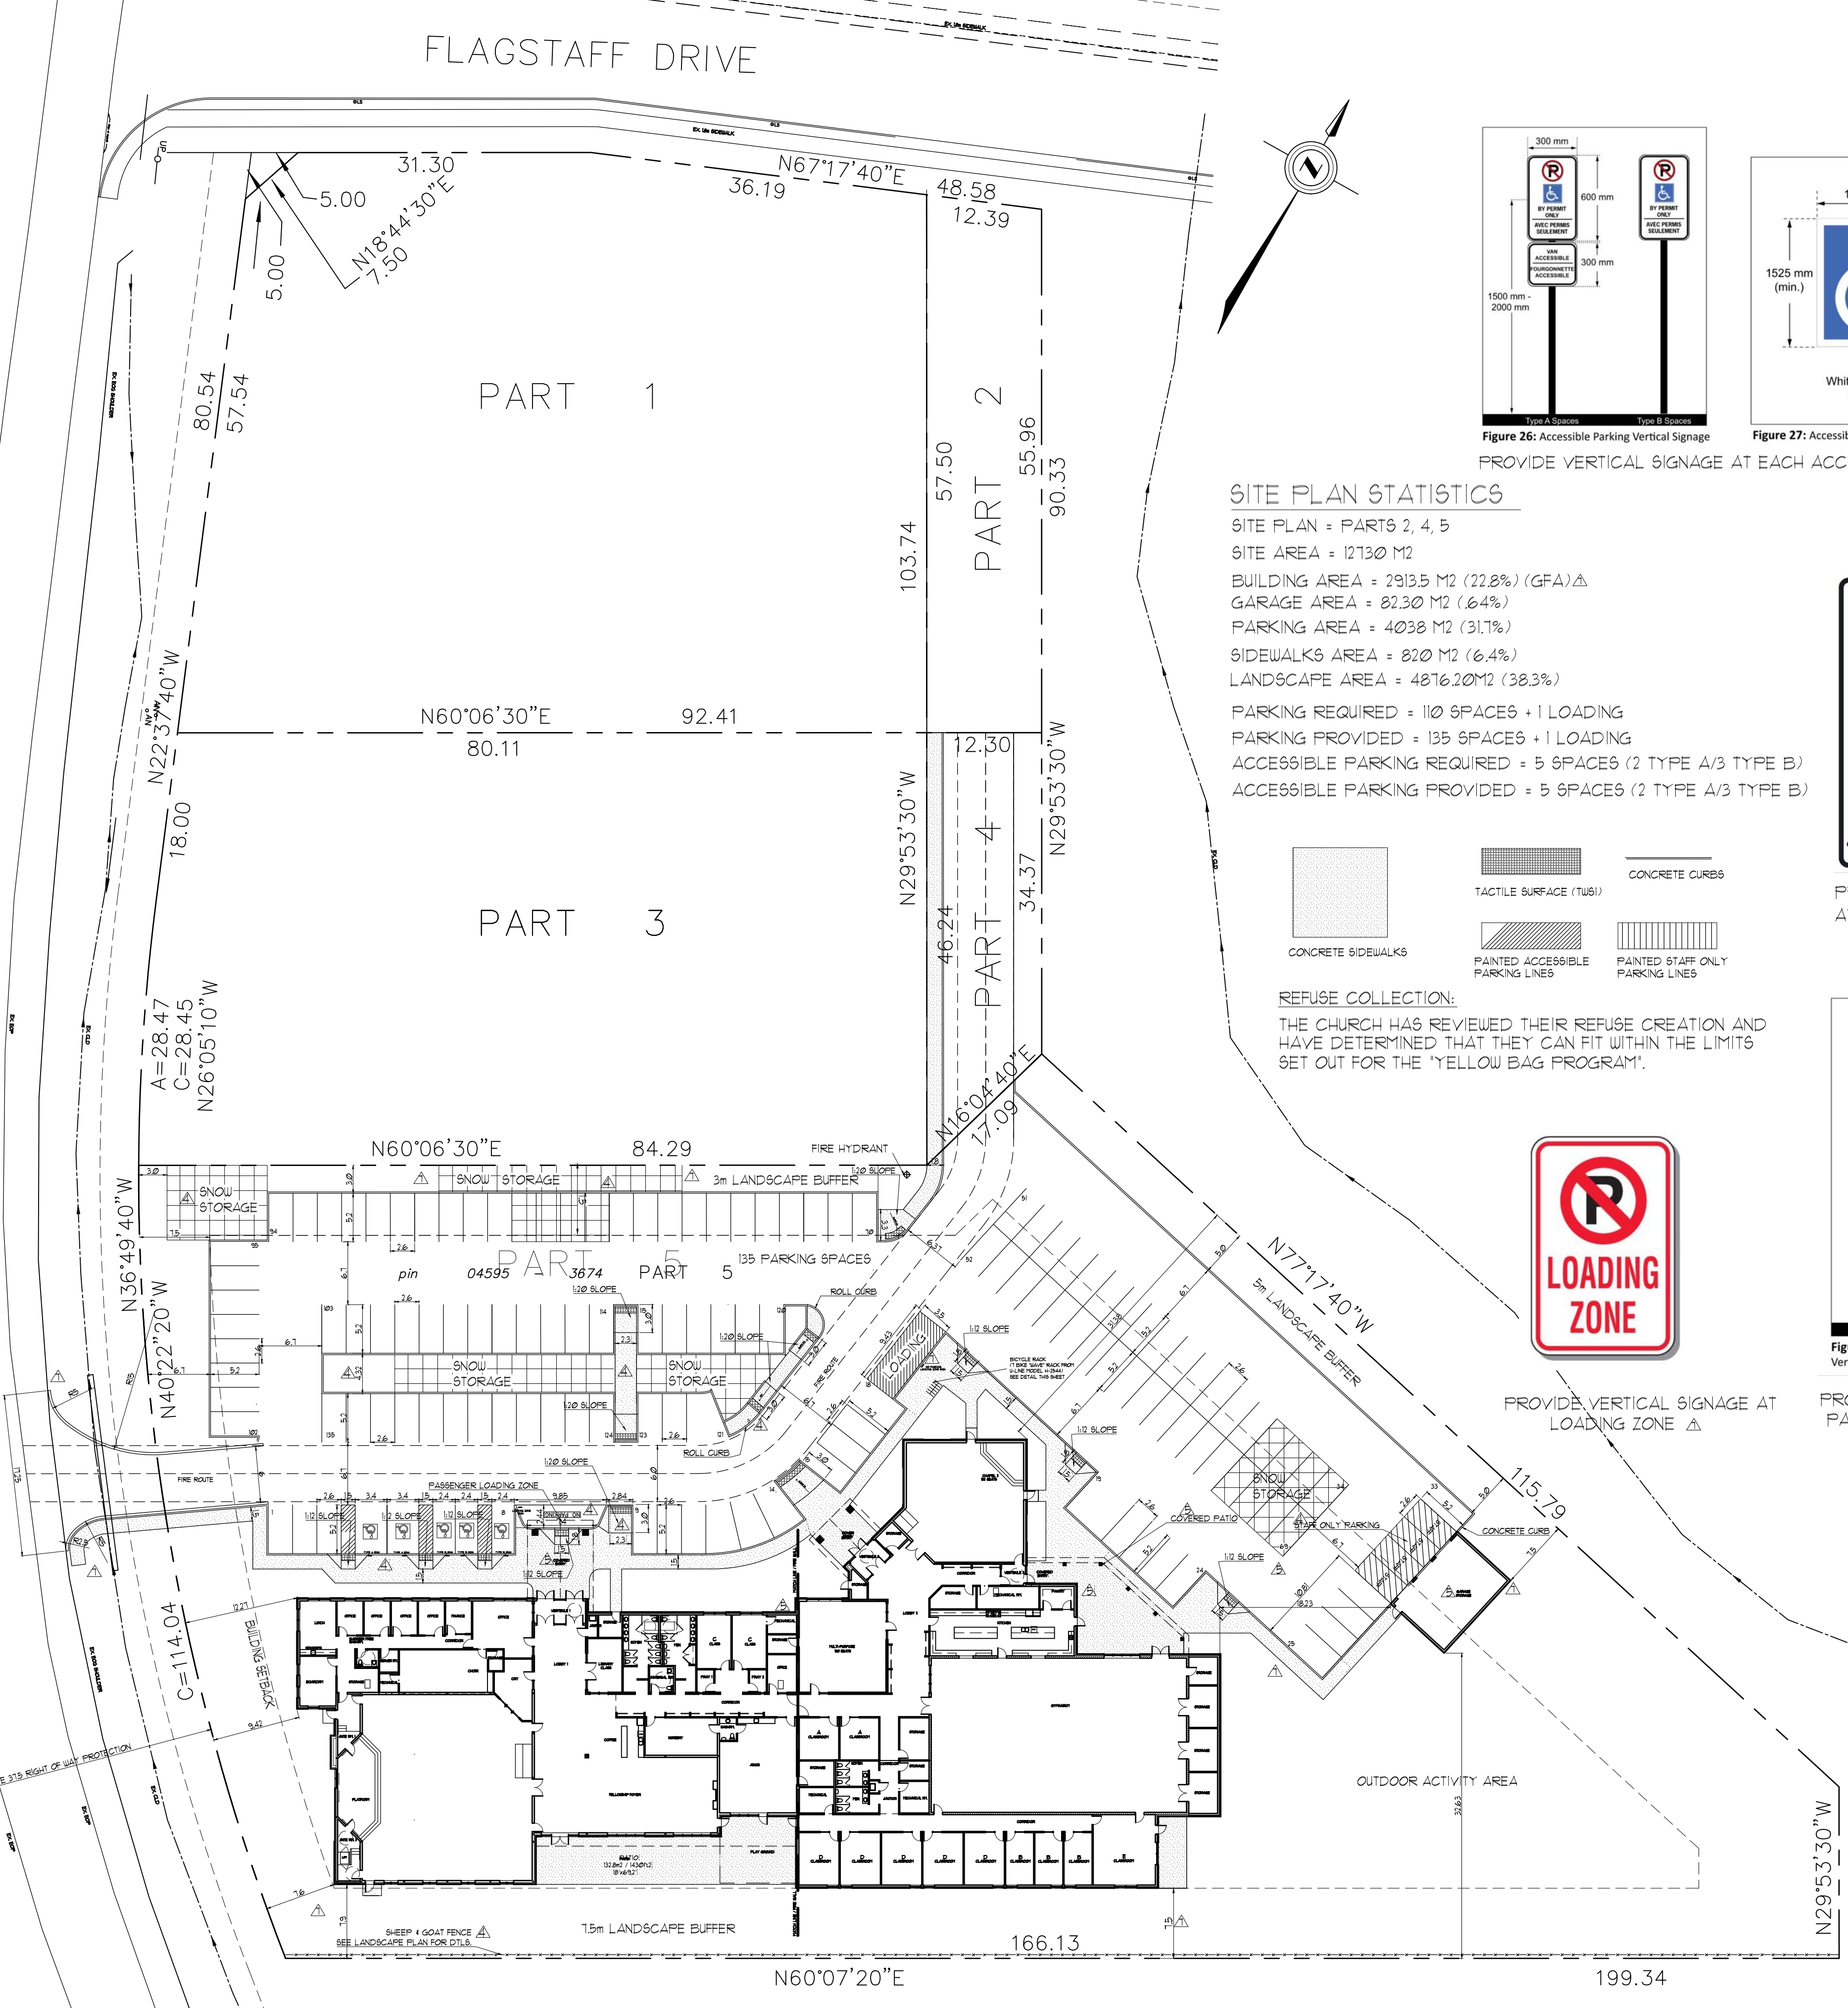

SITE PLAN STATISTICS

SITE PLAN = PARTS 2, 4, 5
 SITE AREA = 12130 M²
 BUILDING AREA = 2913.5 M² (22.8%) Δ
 GARAGE AREA = 82.30 M² (6.4%)
 PARKING AREA = 4038 M² (31.1%)
 SIDEWALKS AREA = 820 M² (6.4%)
 LANDSCAPE AREA = 4816.20 M² (38.3%)
 PARKING REQUIRED = 110 SPACES + 1 LOADING
 PARKING PROVIDED = 135 SPACES + 1 LOADING
 ACCESSIBLE PARKING REQUIRED = 5 SPACES (2 TYPE A/3 TYPE B)
 ACCESSIBLE PARKING PROVIDED = 5 SPACES (2 TYPE A/3 TYPE B)

REFUSE COLLECTION:
 THE CHURCH HAS REVIEWED THEIR REFUSE CREATION AND HAVE DETERMINED THAT THEY CAN FIT WITHIN THE LIMITS SET OUT FOR THE "YELLOW BAG PROGRAM".

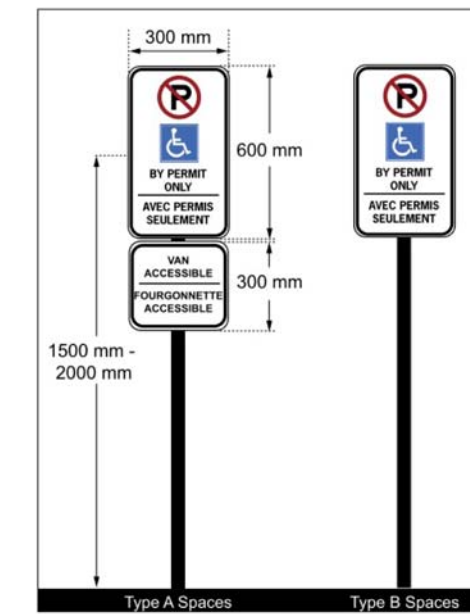


Figure 26: Accessible Parking Vertical Signage


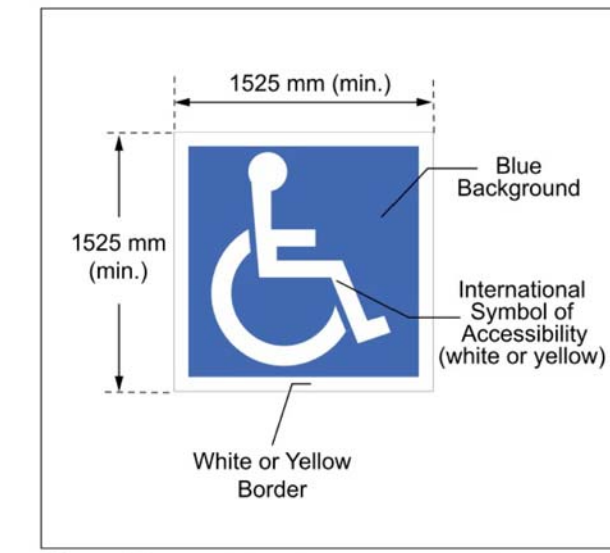


Figure 27: Accessible Parking Pavement Marking

PROVIDE VERTICAL SIGNAGE AT EACH ACCESSIBLE PARKING SPACE



PROVIDE VERTICAL SIGNAGE AT 25 m SPACING MAXIMUM

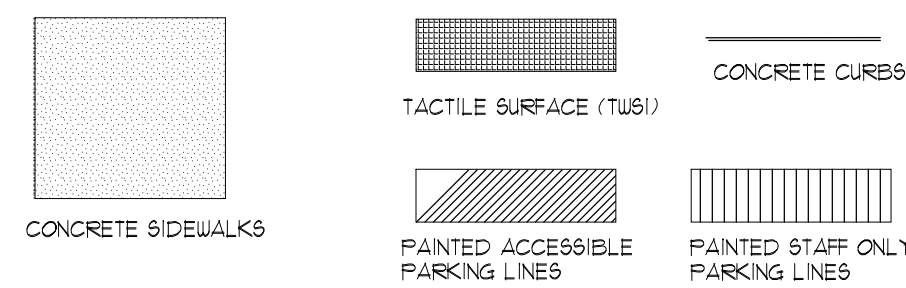

PROVIDE VERTICAL SIGNAGE AT LOADING ZONE Δ

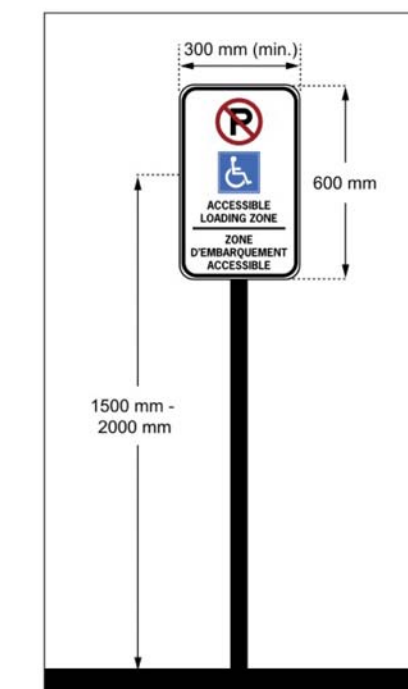


Figure 29: Accessible Loading Zone Vertical Signage

PROVIDE VERTICAL SIGNAGE AT PASSENGER LOADING ZONE

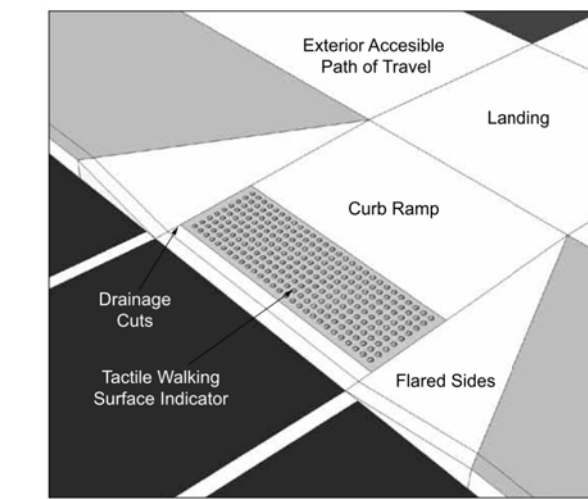


Figure 33a: Typical Curb Ramp

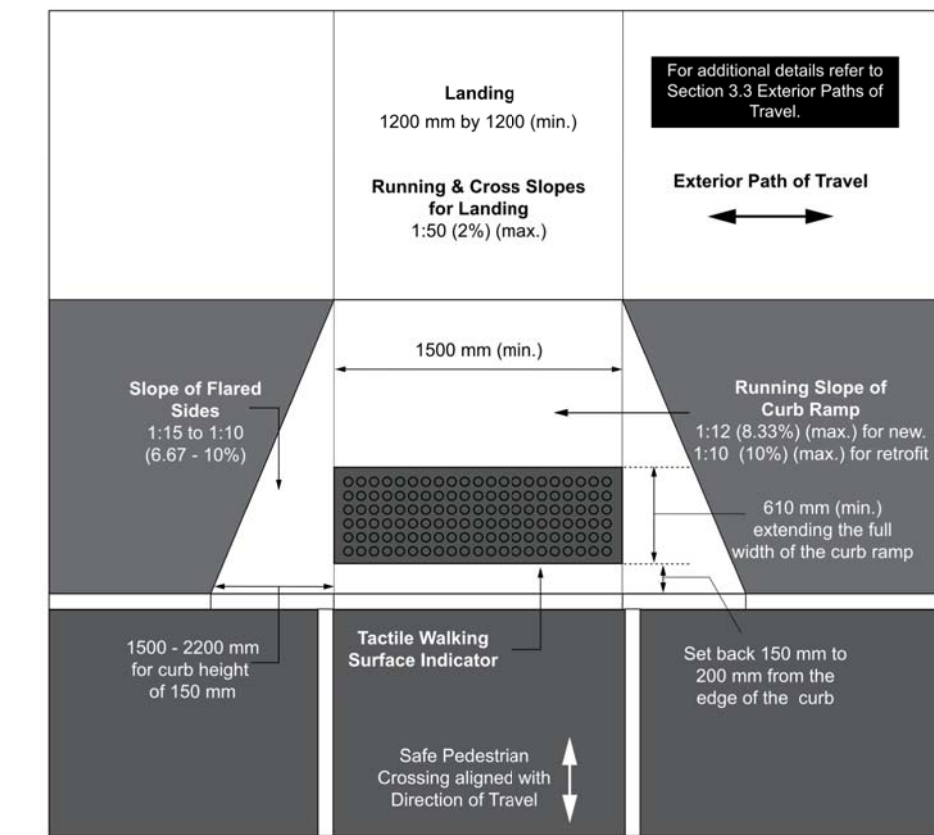


Figure 33b: Typical Curb Ramp Design - Plan View

5-Loop Wave Style Bike Rack - 7 Bike Capacity



BICYCLE RACK
 Refer manufacturers specifications for installation detail



SCALE: 1:400



REVISIONS		
1	SITE PLAN APPLICATION	JUNE 28/23
2	SPA REVIEW COMMENTS	OCT 04/23
3	SPA REVIEW COMMENTS	OCT 30/23
4	SPA REVIEW COMMENTS	JAN 02/24
5	SPA REVIEW COMMENTS	APR 29/24
6	GARAGE + CANOPY CHANGES	JUNE 04/24
7	SPA REVIEW COMMENTS	SEPT 11/24
8		
9		
10		

OTTAWA KOREAN COMMUNITY CHURCH
 3555 BORROSİKANE ROAD
 OTTAWA, ONTARIO

Parker Architects Inc.
 156 St. Paul Street
 St. Catharines, ON, L2R 3M2
 tel: 905-687-6681
 email: info@parkerarchitects.ca

drawing SITE PLAN	
draun DTP	
checked .	
scale 1:400	
NL 22 - 106	date JUNE 28, 2023

TOPOGRAPHICAL PLAN OF SURVEY OF
PART OF LOT 11
CONCESSION 3 (RIDEAU FRONT)
 Geographic Township of Nepean
 CITY OF OTTAWA
 Surveyed by Annis, O'Sullivan, Vollebakk Ltd.

FILE NUMBER D07-12-24-0063
 PLAN NUMBER #18788

COPYRIGHTED: This design is the exclusive property of the architect and shall not be reproduced without the architect's written permission. These drawings are to be used in conjunction with the structural, mechanical and electrical drawings, as well as the specifications. This drawing must not be scaled. All dimensions, data and details shall be verified before construction and alterations or omissions reported immediately to the architect.