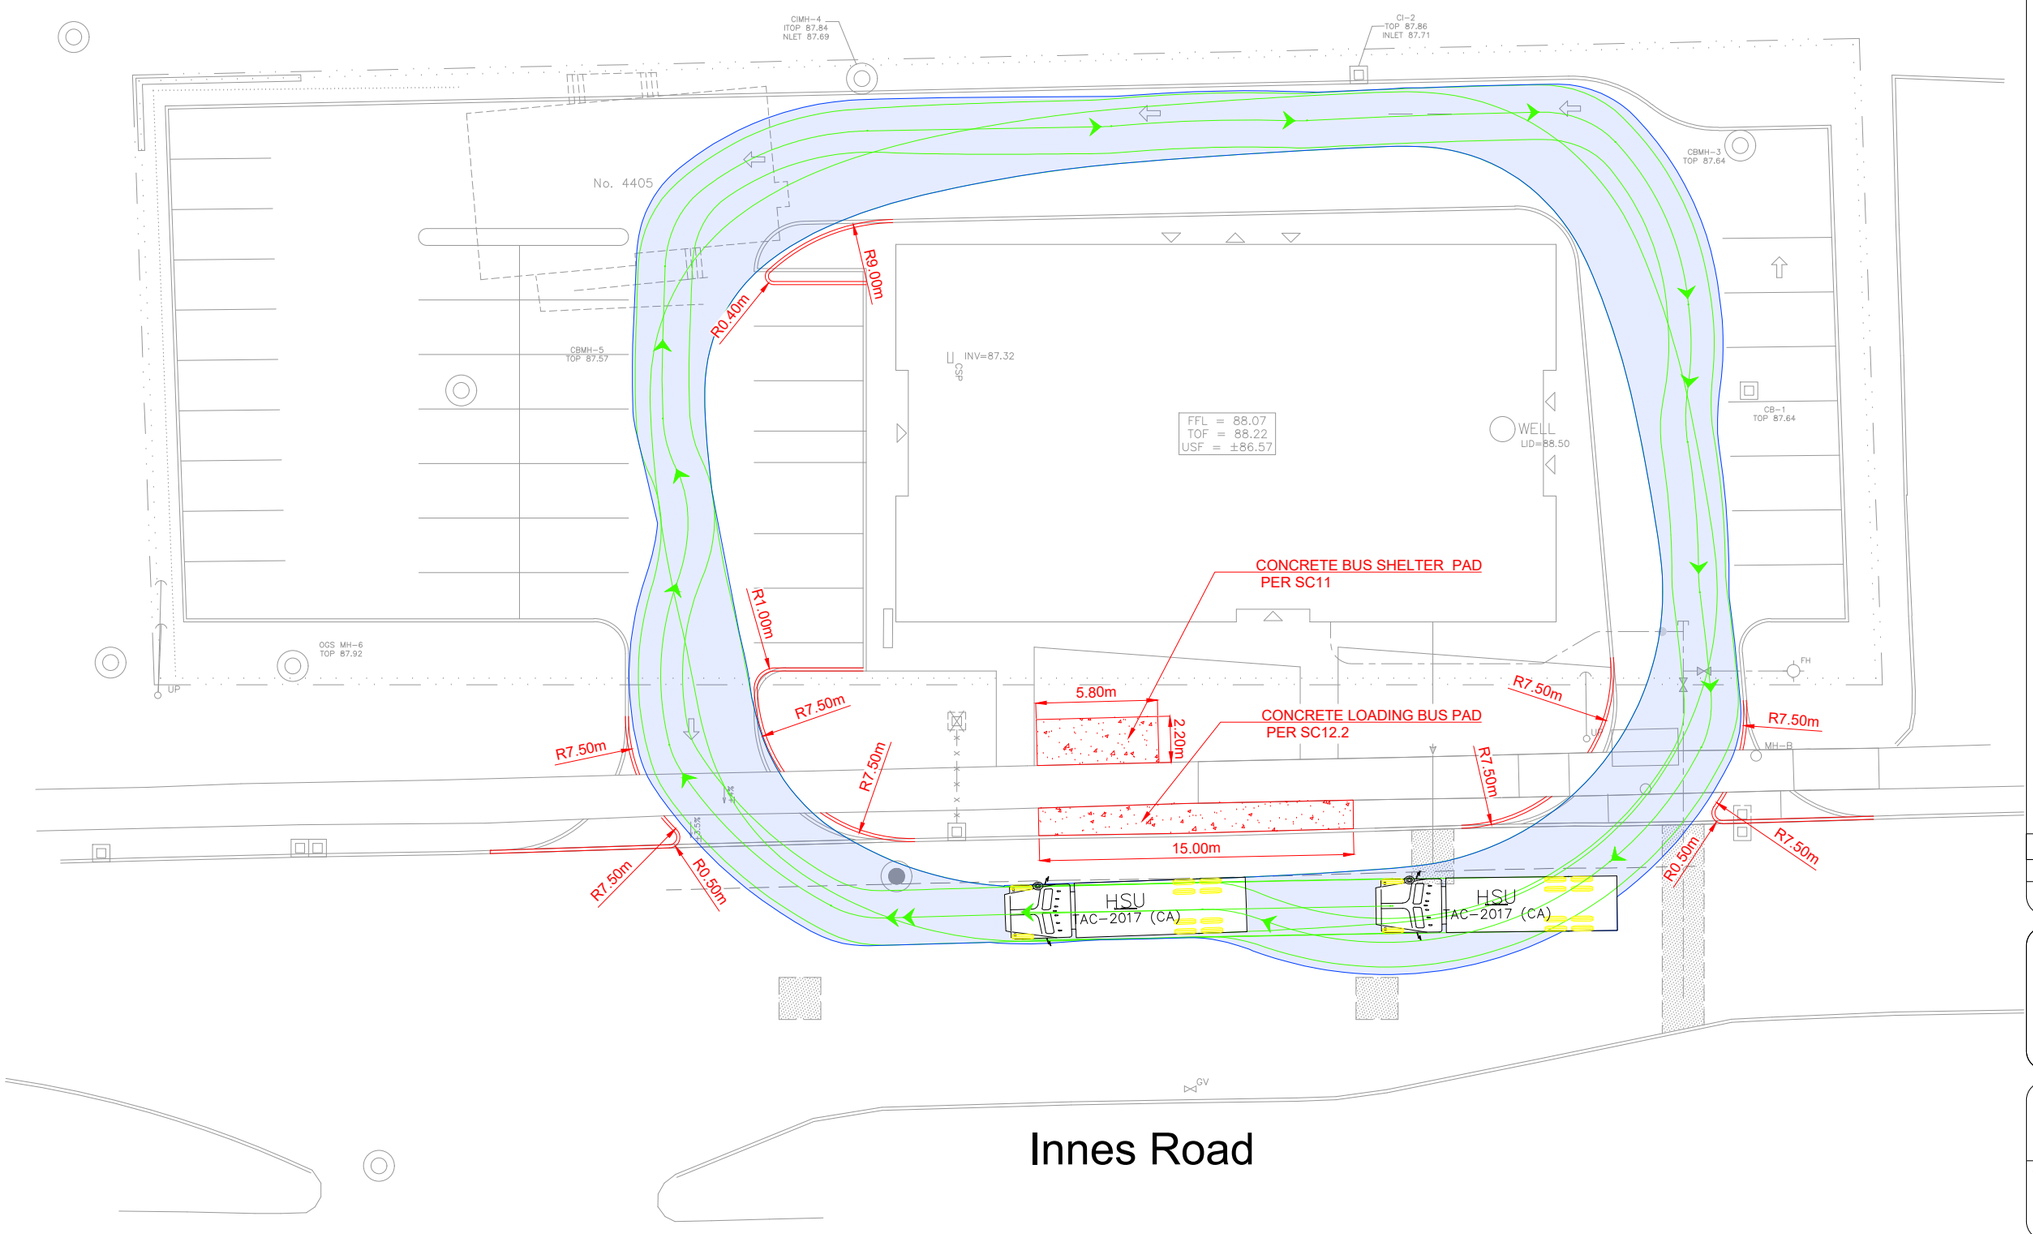

Notes:

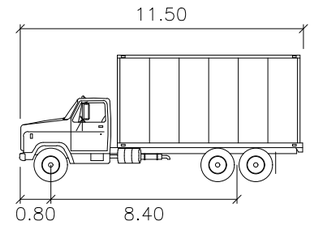

HSU

	meters
Width	: 2.60
Track	: 2.60
Lock to Lock Time	: 6.0
Steering Angle	: 40.0

REV:	DESCRIPTION:	BY:	DATE:
01	Issued for Review:	EA	2025-09-08

STATUS:

CGH Transportation
6 Plaza Court
Ottawa, ON
K2H 7W1
(343) 999-9117

CLIENT:
Marek Janczarski

ARCHITECT:

SITE:
4405-4409 Innes

TITLE:
Geometry Redlines

SCALE AT A3:	DATE:	DRAWN:	CHECKED:
NTS	2025-09-08	EA	JK

PROJECT NO:	DRAWING NO:	REVISION:
2025-159	001	01