
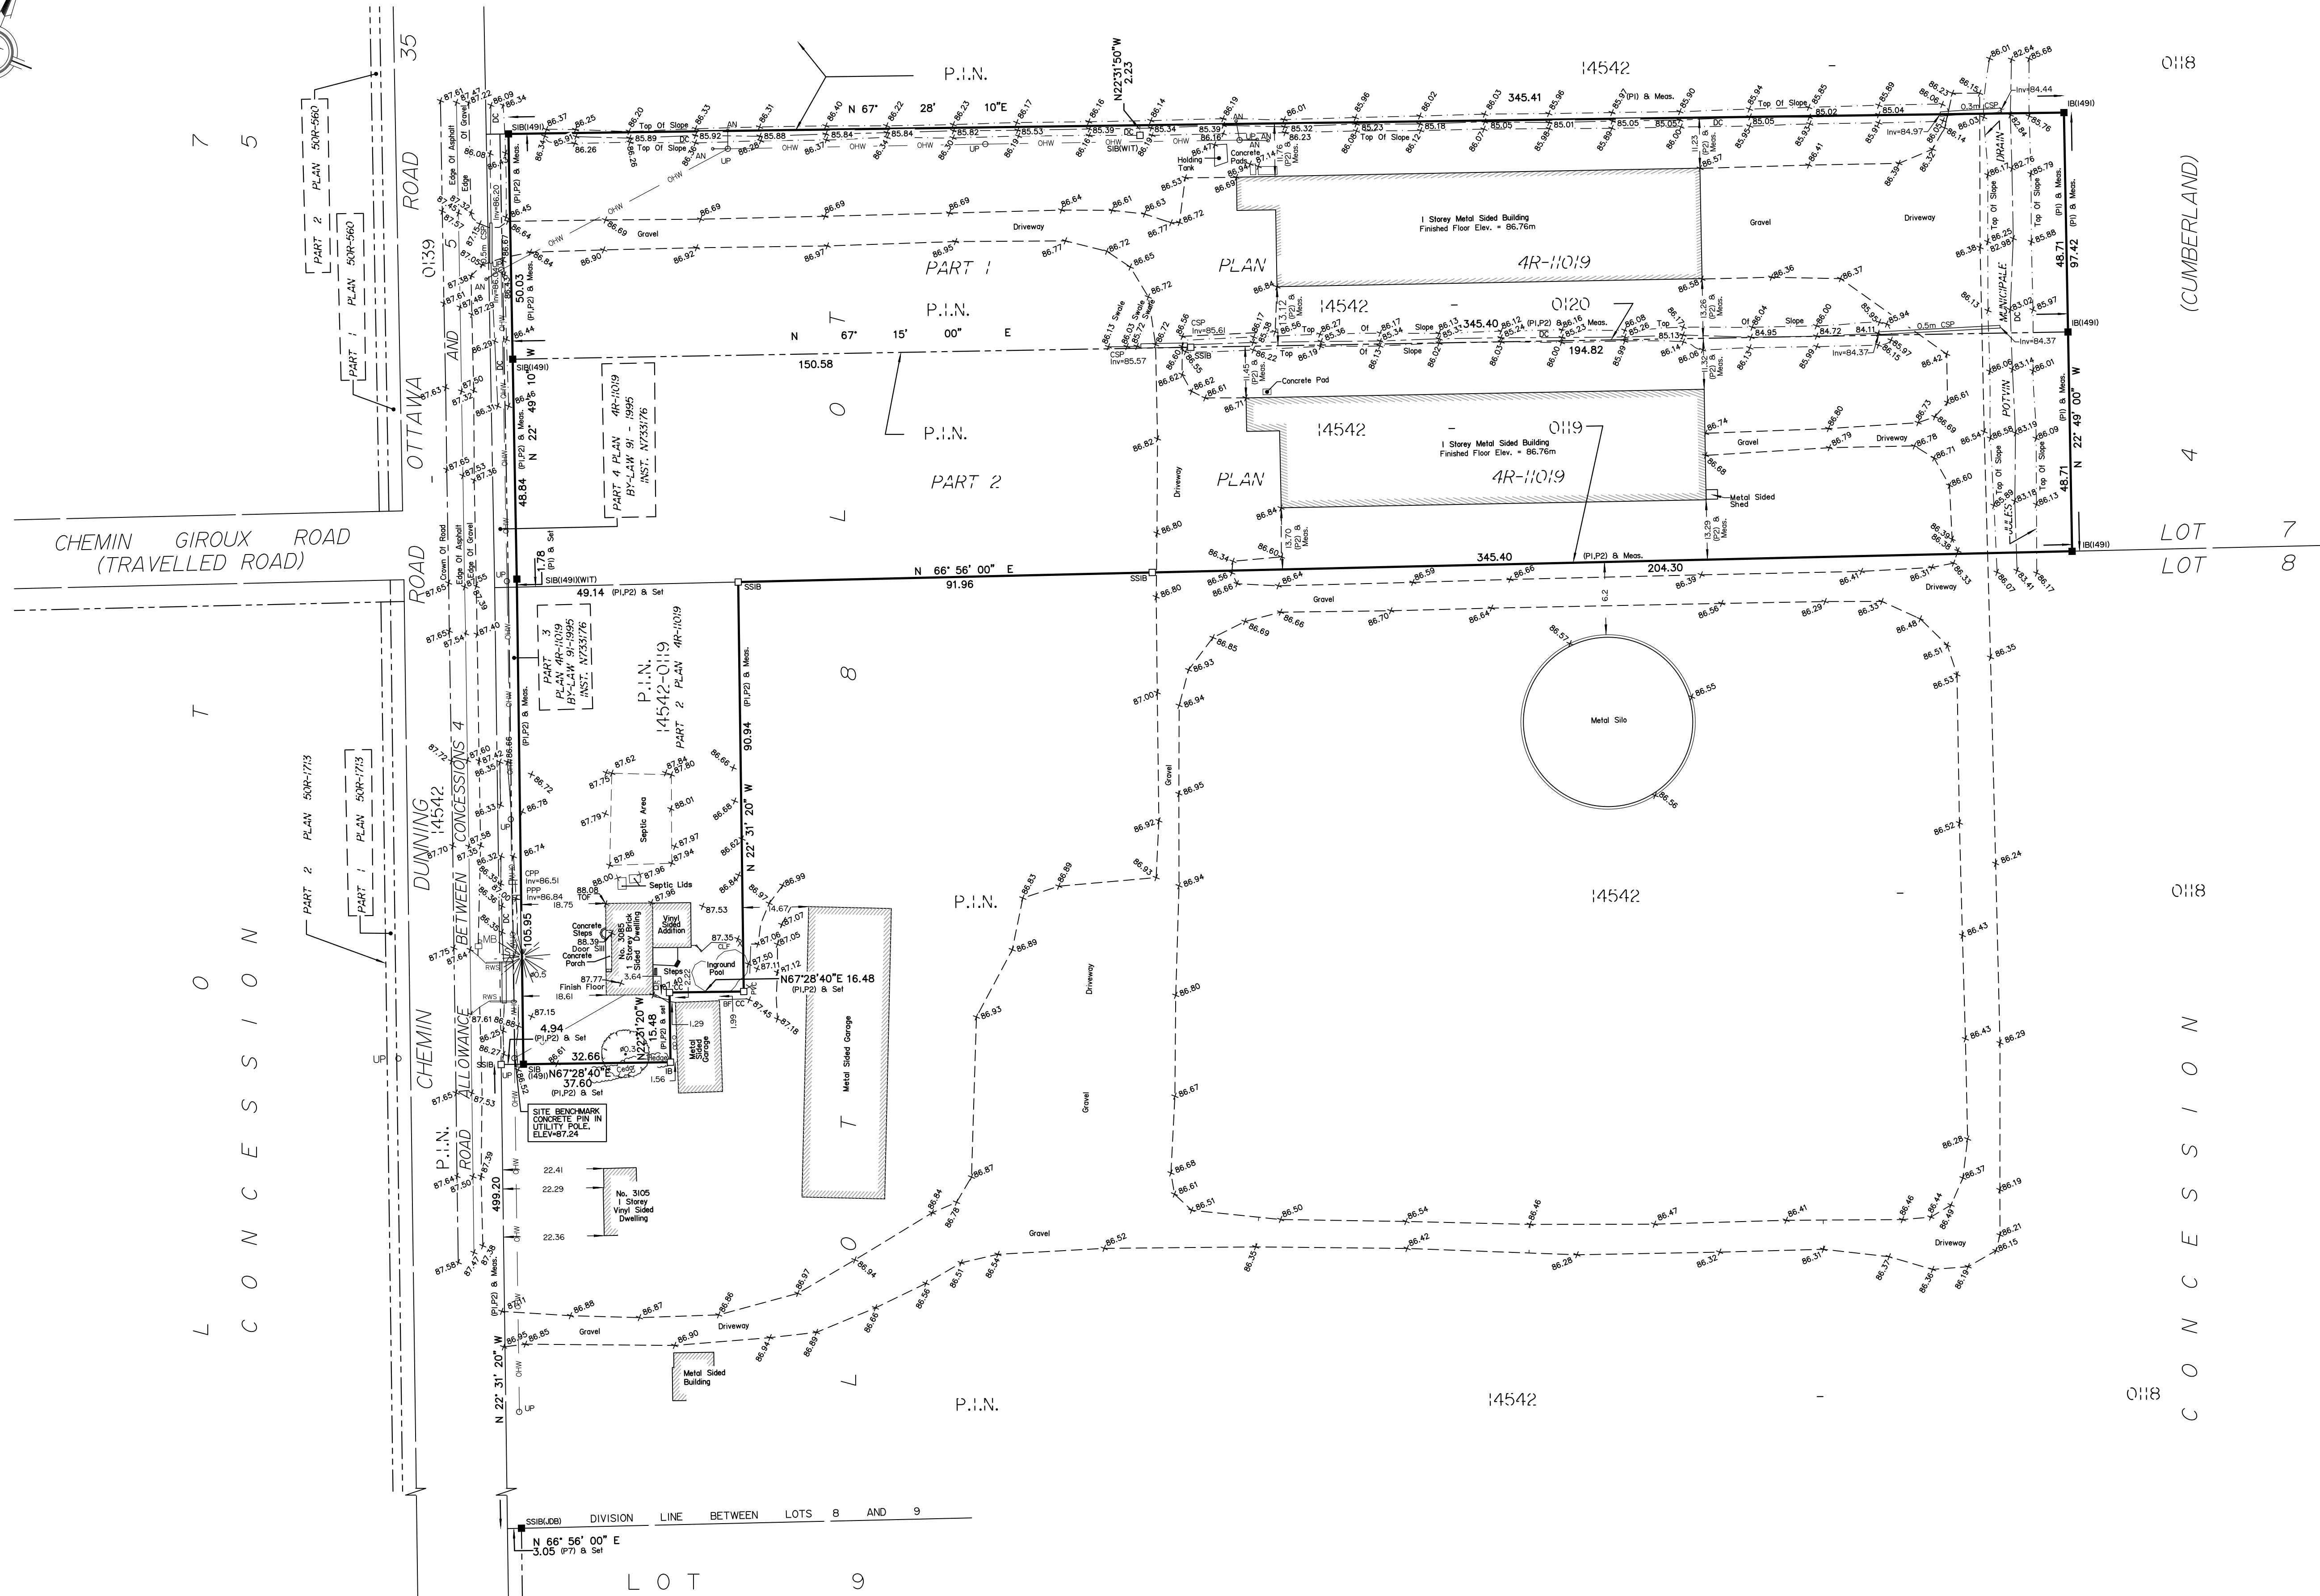


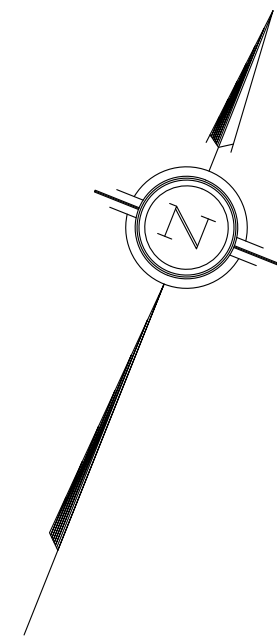

TOPOGRAPHIC PLAN OF SURVEY OF

PART OF LOTS 7 AND 8
CONCESSION 4
GEOGRAPHIC TOWNSHIP OF CUMBERLAND
CITY OF OTTAWA

ARPENTAGE DUTRISAC SURVEYING INC., 2026

Scale 1 : 750



Metric Note

Distances and/or coordinates on this plan are in metres and can be converted to feet by dividing by 0.3048.

Distance Note

Distances shown on this plan are ground distances and can be converted to grid distances by multiplying by the combined scale factor of 0.99999.

Bearing Note

Bearings are grid, derived from Can-Net 3.0 Real Time Network GPS observations and are referred to the Central Meridian of MTM Zone 9 NAD-83 (CSRS) (2010).

- For bearing comparisons, a rotation of 0°47'20" counter-clockwise was applied to bearings on Plan P3 and P4.
- For bearing comparisons, a rotation of 01°01'20" counter-clockwise was applied to bearings on Plan P5 and P6.

Elevation Notes

- Elevations shown are geodetic and are referred to Geodetic Datum CGVD-28-78 and are derived from control monument N° 0011993U867 having a published elevation of 87.496.
- It is the responsibility of the user of this information to verify that the job benchmark has not been altered or disturbed and that its relative elevation and description agrees with the information shown on this drawing.

Notes

All ties to property lines are perpendicular to the property line unless otherwise noted.

Legend

	Denotes	Survey Monument Planted
	"	Survey Monument Found
	"	Standard Iron Bar
	"	Short Standard Iron Bar
	"	Iron Bar
	"	Round Iron Bar
	"	Witness
	"	Measured
	"	Plan 4R-11019
	"	Plan 50R-362
	"	Plan 50R-4876
	"	Plan 4R-9114
	"	Plan 50R-5024
	"	Plan 50R-1528
	"	Utility Pole
	"	Anchor
	"	Top Of Foundation
	"	Corrugated Plastic Pipe
	"	Corrugated Steel Pipe
	"	Perforated Plastic Pipe
	"	Centreline of Ditch
	"	Top of Grate
	"	Inverse
	"	Sign
	"	Chain Link Fence
	"	Board Fence
	"	Polyvinyl Chloride Fence
	"	Stone Retaining Wall
	"	Gate
	"	Mail Box
	"	Air Conditioner
	"	Location of Elevations
	"	Centreline
	"	Property Line
	"	Deciduous Tree
	"	Coniferous Tree

Surveyor's Certificate

I CERTIFY THAT :

- This survey and plan are correct and in accordance with the Surveyors Act, the Surveyors Act and the Land Titles Act and the regulations made under them.
- The survey was completed on the 25th day of June, 2026.

July 3, 2026
Date
Daniel Robinson
Ontario Land Surveyor

This plan of survey relates to AOLS Plan Submission Form Number V-130382

**ADSI**
Arpentage Dutrisc Surveying Inc.Unit 3, 2884 RUE CHAMBERLAND STREET, ROCKLAND, ONTARIO K4K 1M6
TEL: (613) 446-7101 EMAIL: INFO@GEOMATICSADSI.COM

J:\ADSI\jobs\2025147\2025147 Laplante Ptl178& C4 CU O F.dwg

INDEX No.:

CUM-4-7-4

FILE No.: 2025147