
2604 JESSIE CHENEVERT WALK

BLOCK 2 - PHASE 7
RIVERSIDE SOUTH

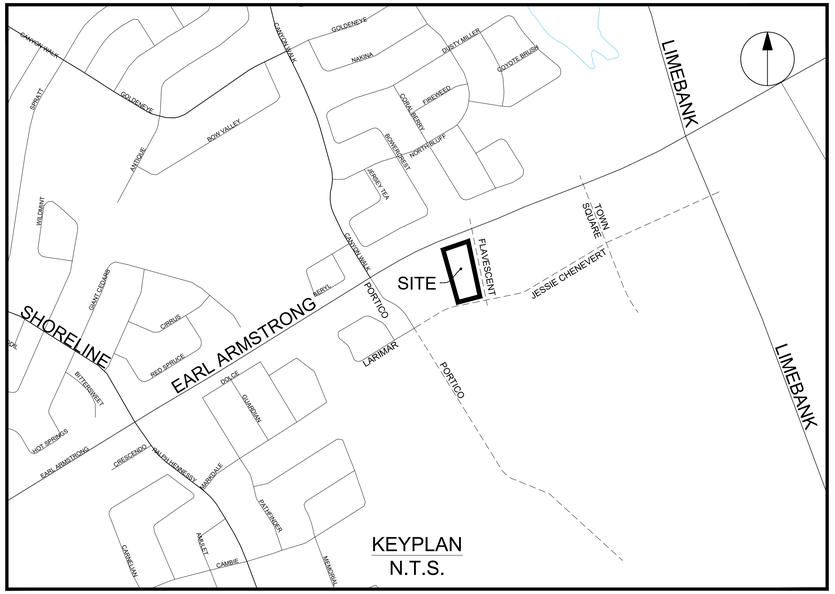

Sheet List Table	
Sheet Number	Sheet Title
--	Cover
C-001	EXISTING CONDITIONS - GENERAL PAN OF SERVICES
C-010	NOTES AND LEGEND
C-200	GRADING PLAN
C-400	SANITARY DRAINAGE PLAN
C-500	STORM DRAINAGE PLAN
C-900	EROSION - SEDIMENT PLAN

ARCADIS

333 Preston Street - Suite 500
Ottawa ON K1S 5N4 Canada
tel 613 225 1311
www.arcadis.com


Urbandale CORPORATION

2193 Arch Street, Ottawa, ON
K1G 2H5


CONTRACT NO. 30339828

SUBMISSION FOR SPA 2026-06-30
CITY FILE No. D07-12-25-0150 CITY PLAN No. 19413

D:\Users\jvanbuskirk\ADSC\Documents\ACC_ATVACI-_3339828_2604 Jessie Chenevert Walk\Project Files\10_BIM\04_Civil\Sheets\Cover.rvt Layout: Name: Cover Plot Style: ---- Plot Scale: 1:1429 Printed At: 4/30/2026 7:44 AM Last Saved By: ATVACI-3339828 Last Saved At:

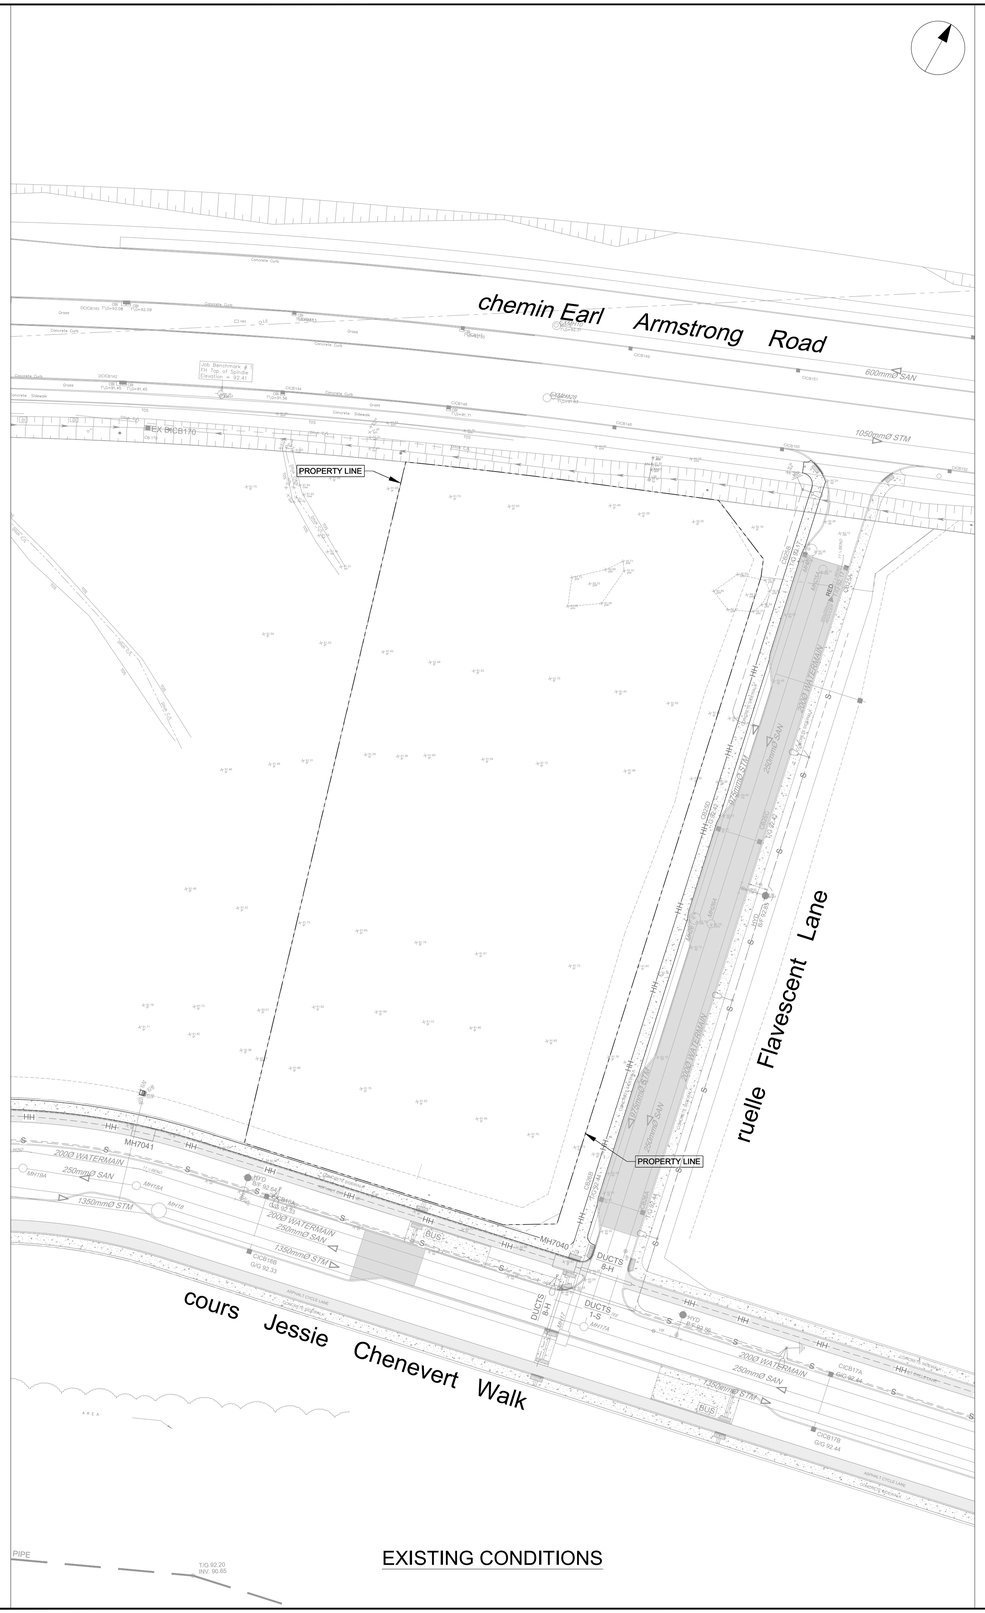

EXISTING CONDITIONS

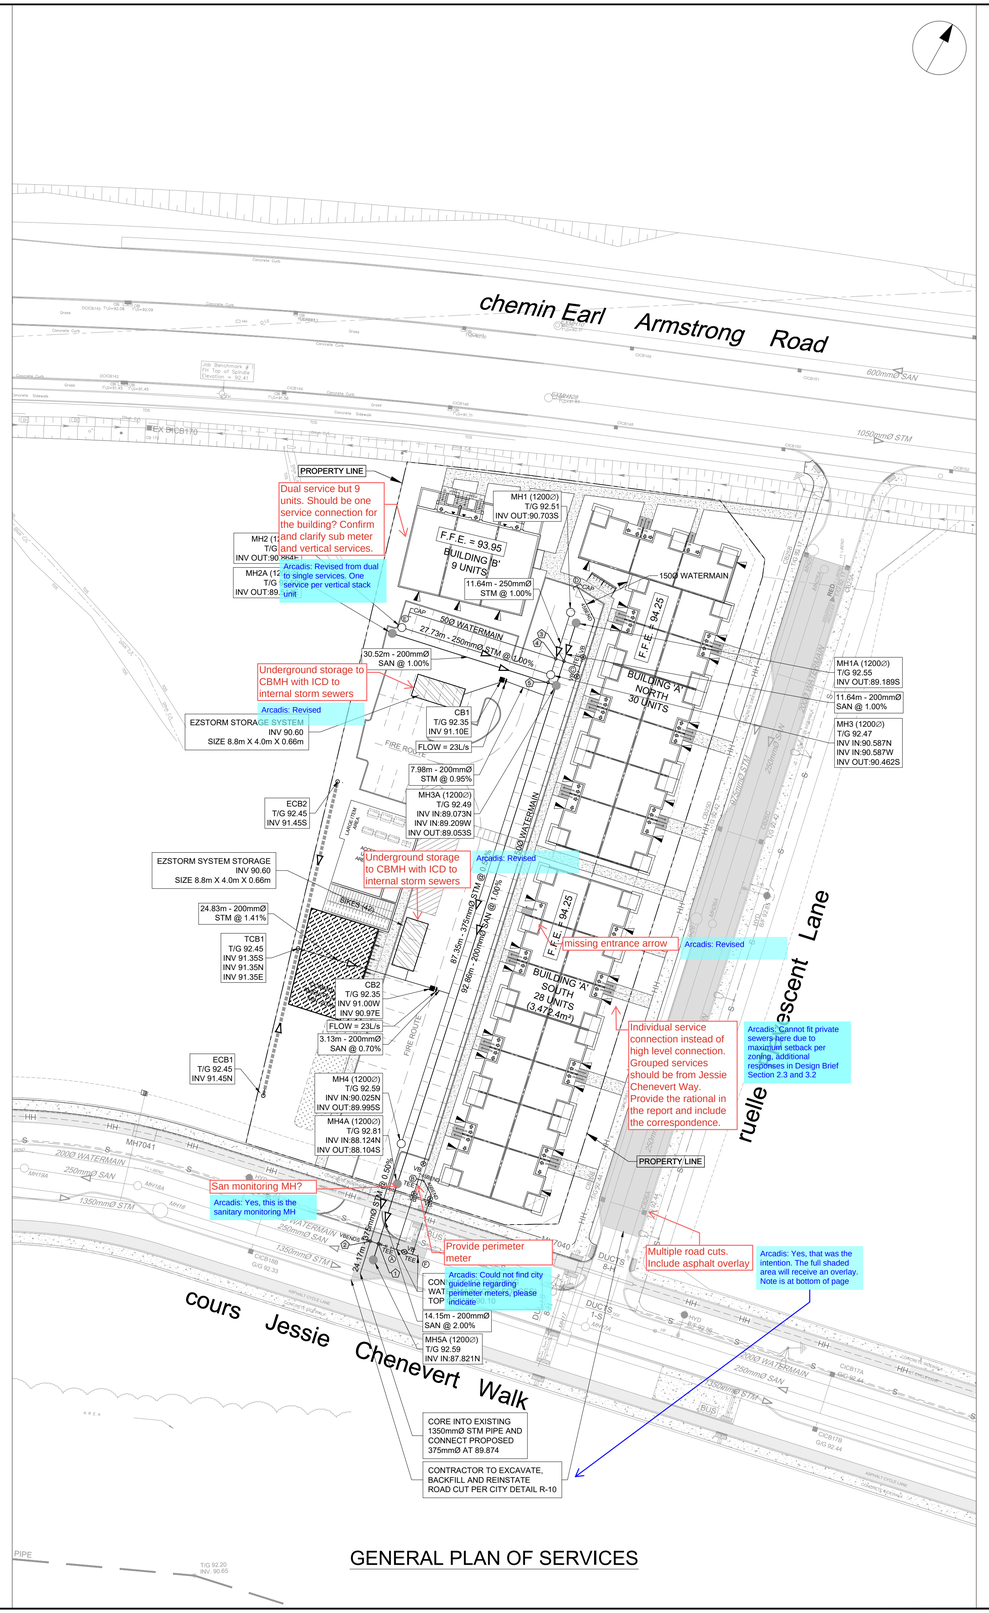

GENERAL PLAN OF SERVICES

CLIENT

Urbandale CORPORATION

2193 Arch Street, Ottawa, ON
K1G 2H5

COPYRIGHT
This drawing has been prepared solely for the intended use, thus any reproduction or distribution for any purpose other than authorized by Arcadis is forbidden. Written dimensions shall have precedence over scaled dimensions. Contractors shall verify and be responsible for all dimensions and conditions on the job, and Arcadis shall be informed of any variations from the dimensions and conditions shown on the drawing. Shop drawings shall be submitted to Arcadis for general conformance before proceeding with fabrication.

ISSUES

No.	DESCRIPTION	DATE
1	ISSUED FOR COORDINATION	2026-06-08
2	SUBMISSION FOR SPA	2026-06-30
3	-	-
4	-	-

NOT FOR CONSTRUCTION

SEE SHT 10 FOR NOTES, LEGEND, CB TABLE, STREET SECTIONS AND DETAILS

KEY PLAN



1:500

CONSULTANTS

SEAL

LICENCED PROFESSIONAL ENGINEER
S. E. LABADIE
100214983
2026/06/30
PROVINCE OF ONTARIO

PROJECT
2604 JESSIE CHENEVERT WALK

PROJECT NO:	
30339828	Site plan and Plan Number
DRAWN BY: C.C./D.D.	CHECKED BY: T.R.B.
PROJECT MGR: S.E.L.	APPROVED BY: S.E.L.

SHEET TITLE
EXISTING CONDITIONS - GENERAL PAN OF SERVICES

SHEET NUMBER	ISSUE
C-001	1

SCALE CHECK | Scale

File Location: C:\Users\hennie6006\DC\ACCDocs\Arcadis ACC USA\CA-30339828-2604 Jessie Chenevert Walk\Project Files\10_WIP\04_CIVIL\Sheets\C-001 SITE PLAN SERVICING.dwg Last Saved: June 30, 2026, by hennie6006 Plotted: June 30, 2026 7:54:45 AM by Hennie, Eric

FILE # D07-XX-XX-XXXX

PLAN # XXXX

GENERAL LEGEND

- LIMIT OF CONSTRUCTION
- PHASING LINE
- BARRIER CURB
- MOUNTABLE CURB
- DEPRESSED BARRIER CURB
- CONCRETE SIDEWALK
- TACTILE WALKING SURFACE INDICATOR
- ASPHALT SIDEWALK / PATHWAY
- BUS STOP CONCRETE / ASPHALT

SERVICING LEGEND

- SANITARY MANHOLE
- SANITARY SEWER
- STORM MANHOLE
- STORM SEWER - LESS THAN 900Ø
- STORM SEWER - 900Ø AND GREATER
- WATERMAIN
- STREET CATCHBASIN C/W TOP OF GRATE
- CURB INLET CATCHBASIN C/W GUTTER GRADE
- DOUBLE CATCHBASIN C/W TOP OF GRATE
- DOUBLE CURB INLET CATCHBASIN C/W GUTTER GRADE
- DITCH INLET MANHOLE C/W TOP OF GRATE
- CATCHBASIN MANHOLE C/W TOP OF GRATE
- REAR YARD CATCHBASIN IN ROAD CONNECTING STRUCTURE C/W SOLID GRATE
- REAR YARD "TEE" CATCHBASIN (300Ø) C/W TOP OF GRATE AND INVERT OUT
- REAR YARD "END" CATCHBASIN (300Ø) C/W TOP OF GRATE AND INVERT OUT
- REAR YARD "CUSTOM ANGLED " CATCHBASIN (450Ø) C/W TOP OF GRATE AND INVERT OUT
- REAR YARD "THREE WAY" CATCHBASIN (450Ø) C/W TOP OF GRATE AND INVERT OUT
- PERFORATED REAR YARD SUBDRAIN
- CSP CULVERT C/W DIAMETER
- VALVE AND VALVE BOX
- VALVE AND VALVE CHAMBER
- PARK VALVE CHAMBER C/W SERVICE POST
- FIRE HYDRANT C/W BOTTOM OF FLANGE ELEVATION
- WATERMAIN REDUCER
- VERTICAL BEND LOCATION
- SIAMESE CONNECTION (IF REQUIRED)
- METER (IF REQUIRED)
- REMOTE METER (IF REQUIRED)
- WATERMAIN IDENTIFICATION (IF REQUIRED)
- PIPE CROSSING IDENTIFICATION (IF REQUIRED)
- SINGLE SERVICE LOCATION
- DOUBLE SERVICE LOCATION
- SINGLE SERVICE LOCATION (REQUIRES FOUNDATION SLEEVE)
- INFERRED REFUSAL (SEE GEOTECHNICAL REPORT)
- 100 YEAR STORM HYDRAULIC GRADE LINE AT MANHOLE
- UNDERSIDE OF FOOTING ELEVATION
- CLAY SEAL IN SEWER / WATERMAIN TRENCH

AOV LEGEND

- Maintenance Hole (Storm Sewer)
- Maintenance Hole (Sanitary)
- Maintenance Hole (Traffic)
- Maintenance Hole (Hydro)
- Valve Chamber (Watermain)
- Overhead Wires
- Utility Pole
- Anchor
- Hydro Transformer Mounted on Utility Pole
- Light Standard
- Catch Basin
- Catch Basin Inlet
- Ditch Inlet
- Fire Hydrant
- Water Valve
- Handhole
- Diameter
- Location of Elevations
- Top of Concrete Curb Elevation
- Centreline
- Property Line
- Proposed Property Line per Draft Plan of Subdivision Concept Plan March 26, 2024.
- Top of Slope
- Bottom of Slope
- Traffic Light

WATERMAIN SCHEDULE

	Station	Description	Finished Grade	Top of Watermain	Watermain Cover	As Built Watermain
A	0+000.00	CONNECT TO EXISTING 200Ø WM	92.518	90.118	2.400	*90.10*
	0+004.02		92.600	90.200	2.400	
	0+009.95	PROPERTY LINE	92.850	90.450	2.400	
	0+010.36	VB	92.840	90.440	2.400	
B	0+013.06	150x150 TEE	92.800	90.400	2.400	
	0+015.93	VB	92.760	90.360	2.400	
	0+024.02		92.540	90.140	2.400	
	0+034.02		92.530	90.130	2.400	
	0+044.02		92.530	90.130	2.400	
	0+054.02		92.530	90.130	2.400	
	0+064.02		92.540	90.140	2.400	
	0+074.02		92.630	90.230	2.400	
	0+084.02		92.570	90.170	2.400	
	0+094.02		92.540	90.140	2.400	
	0+104.02		92.540	90.140	2.400	
	0+106.61	VB	92.540	90.140	2.400	
C	0+108.50	150x150 TEE	92.540	90.140	2.400	
	0+110.26	VB	92.540	90.140	2.400	
	0+114.02		92.540	90.140	2.400	
	0+117.14	45 BEND	92.550	90.150	2.400	
D	0+124.02	CAP	92.700	90.300	2.400	
B	0+000.00	150x150 TEE	92.800	90.400	2.400	
	0+001.02	VB	92.810	90.410	2.400	
	0+003.84	45 BEND	92.890	90.490	2.400	
	0+004.54	45 BEND	92.880	90.480	2.400	
	0+004.95	PROPERTY LINE	92.870	90.470	2.400	
F	0+014.91	CONNECT TO EXISTING 200Ø WM	92.540	90.140	2.400	*90.10*
C	0+000.00	CAP	92.490	90.090	2.400	
	0+010.00		92.450	90.050	2.400	
	0+019.00		92.430	90.030	2.400	
	0+030.00		92.510	90.110	2.400	
E	0+031.76	150x150 TEE	92.540	90.140	2.400	

REVISED 2026-06-29

Pipe Interference Table

Crossing No.	PIPE 1	PIPE 2	Clearance
1	WTR Bottom 90.79	SAN Top 88.99	2.70
2	WTR Bottom 90.79	STM Top 90.29	0.50
3	SAN Bottom 89.11	WTR Top 87.90	1.31
4	STM Bottom 90.81	WTR Top 87.81	2.90
5	STM Bottom 90.44	SAN Top 89.43	1.01

NOTES :

1. ALL MATERIALS AND CONSTRUCTION IS TO BE IN ACCORDANCE WITH THE CURRENT CITY OF OTTAWA STANDARD DRAWINGS & SPECIFICATIONS OR OPSD/OPSS IF CITY DRAWINGS AND SPECIFICATIONS DO NOT APPLY.
2. THE POSITION OF UNDERGROUND AND ABOVE GROUND SERVICE, UTILITIES AND STRUCTURES ARE NOT NECESSARILY SHOWN ON THE CONTRACT DRAWINGS, AND WHERE SHOWN, THE ACCURACY OF THE POSITION OF SUCH SERVICE, UTILITIES AND STRUCTURES IS NOT GUARANTEED. THE CONTRACTOR IS RESPONSIBLE FOR DETERMINING THE EXACT LOCATION, SIZE, MATERIAL AND ELEVATION OF ALL EXISTING SERVICES AND UTILITIES PRIOR TO CONSTRUCTION.
3. THE CONTRACTOR SHALL REPORT ALL CONFLICTS, DISCOVERIES OF ERROR AND DISCREPANCIES TO THE ENGINEER.
4. THE CONTRACTOR SHALL BE RESPONSIBLE TO PROTECT AND ASSUME RESPONSIBILITY FOR ALL UTILITIES WHETHER OR NOT SHOW ON THESE DRAWINGS.
5. THE CONTRACTOR SHALL BE RESPONSIBLE TO PROTECT ALL LANDS BEYOND THE SITE LIMITS. ANY AREAS BEYOND THE SITE LIMITS, WHICH ARE DISTURBED DURING CONSTRUCTION, SHALL BE REPAIRED AND RESTORED TO ORIGINAL CONDITION OR BETTER, TO THE SATISFACTION OF THE ADJACENT LAND OWNER, THE OWNER, THE OWNERS REPRESENTATIVES AND/OR THE AUTHORITY HAVING JURISDICTION AT THE EXPENSE OF THE CONTRACTOR.
6. WHERE NECESSARY, THE CONTRACTOR SHALL IMPLEMENT A TRAFFIC MANAGEMENT PLAN TO THE SATISFACTION OF THE CITY OF OTTAWA. ALL CONSTRUCTION SIGNAGE MUST CONFORM TO THE LATEST VERSION OF THE M.T.O. MANUAL OF UNIFORM TRAFFIC CONTROL DEVICES. ALL TEMPORARY TRAFFIC CONTROL MEASURES MUST BE REMOVED UPON THE COMPLETION OF THE WORKS.
7. SHOULD ANY BURIED ARCHAEOLOGICAL REMAINS BE FOUND ON THE PROPERTY DURING CONSTRUCTION ACTIVITIES, THE CONTRACTOR SHALL NOTIFY THE OWNER TO CONTACT THE HERITAGE OPERATIONS UNIT OF THE ONTARIO MINISTRY OF CULTURE MUST BE NOTIFIED IMMEDIATE, AND WORK WITHIN THE AREA SHALL BE CEASED UNTIL FURTHER NOTICE.
8. FOR SITE PLAN INFORMATION, REFER TO SITE PLAN PREPARED BY RLA ARCHITECTURE.
9. THESE DRAWINGS ARE NOT TO BE SCALED OR USED FOR LAYOUT PURPOSES
10. ROADWAY SECTIONS REQUIRING GRADE RAISE TO PROPOSED SUB GRADE LEVEL TO BE FILLED WITH ACCEPTABLE NATIVE EARTH BORROW OR IMPORTED OPSS SELECTED SUBGRADE MATERIAL IF NATIVE MATERIAL IS DEFICIENT AS PER RECOMMENDATION OF GEOTECHNICAL ENGINEER.
11. IN AREAS WHERE EXISTING GROUND IS BELOW THE PROPOSED ELEVATION OF SEWER AND WATERMAINS, GRADE RAISING AND FILLING IS TO BE IN ACCORDANCE WITH THE RECOMMENDATIONS OF THE GEOTECHNICAL REPORT. AS PER CITY GUIDELINES ALL WATERMAINS IN FILL AREAS ARE TO BE TIED WITH RESTRAINING JOINTS AND THRUST BLOCKS.
12. THE CONTRACTOR SHALL IMPLEMENT THE EROSION AND SEDIMENT CONTROL PLAN PRIOR TO THE COMMENCEMENT OF ANY SITE CONSTRUCTION. ALL EROSION AND SEDIMENT CONTROL MEASURES SHALL BE INSTALLED TO THE SATISFACTION OF THE ENGINEER, OR ANY REGULATORY AGENCY. ALL EROSION AND SEDIMENT CONTROL MEASURES SHALL BE MAINTAINED UNTIL VEGETATION IS ESTABLISHED OR UNTIL THE START OF A SUBSEQUENT PHASE.
13. CONTRACTORS SHALL BE RESPONSIBLE FOR KEEPING CLEAN ALL ROADS WHICH BECOME COVERED IN DUST, DEBRIS AND/OR MUD AS A RESULT OF ITS CONSTRUCTION OPERATIONS.
14. THE CONTRACTOR SHALL BE RESPONSIBLE FOR ANY ADDITIONAL BEDDING OR ADDITIONAL STRENGTH PIPE SHOULD THE MAXIMUM OPSD TRENCH WIDTH BE EXCEEDED.
15. ALL PIPE, CULVERTS, STRUCTURES REFER TO NOMINAL INSIDE DIMENSIONS.
16. SHOULD CLAY SEALS BE REQUIRED, THEY SHALL BE INSTALLED AS PER THE RECOMMENDATIONS WITHIN THE GEOTECHNICAL REPORT.
17. UNLESS SPECIFICALLY NOTED OTHERWISE, PIPE MATERIALS SHALL BE AS FOLLOWS;
    -WATERMAINS TO BE PVC DR18
    -SANITARY SEWER TO BE PVC DR35
    -PERFORATED STORM SEWERS IN REAR YARDS AND LANDSCAPE AREAS TO BE HDPE
    -STORM SEWERS 375mm DIAMETER AND LESS TO BE PVC DR35
    -STORM SEWERS 450mm DIAMETER AND GREATER TO BE CONCRETE, CLASS AS PER OPSD 807.010 OR 807.030, OR HIGHER
    FOR SHALLOW SEWERS, REFER TO CITY STANDARD S35.
18. ALL CONNECTIONS TO EXISTING WATERMAINS ARE TO BE COMPLETED BY CITY FORCES. CONTRACTOR IS TO EXCAVATE, BACKFILL, COMPACT AND REINSTATE.
19. ANY WATERMAIN WITH LESS THAN 2.4m AND ANY SEWER WITH LESS THAN 2.0m DEPTH OF COVER REQUIRES THERMAL INSULATION AS PER CITY OF OTTAWA STANDARD W22 OR AS APPROVED BY THE ENGINEER.
20. ALL FIRE HYDRANTS AS PER CITY STANDARD W19, c/w 150mmØ LEAD UNLESS OTHERWISE SPECIFIED.
21. ALL STUBBED SEWERS SHALL HAVE PRE-MANUFACTURED CAPS INSTALLED.
22. ALL CATCHBASINS SHALL HAVE A 600mm SUMP. ALL CATCHBASIN MANHOLES, AND ALL STORM MANHOLES WITH OUTLETTING PIPE SIZES LESS THAN 900mm, SHALL HAVE A 300mm SUMP.
23. ALL SANITARY MANHOLES IN PONDING AREAS SHALL BE EQUIPPED WITH A WATERTIGHT COVER.
24. ALL LEADS FOR STREET CATCHBASIN'S AND CURB INLET CATCHBASIN'S CONNECTED TO MAIN SHALL BE 200mmØ PVC DR35 @ MIN 2% SLOPE UNLESS NOTED OTHERWISE. ALL LEADS FOR RYCB'S CONNECTED TO MAIN SHALL BE 200mmØ PVC DR35 @ MIN 1% SLOPE UNLESS NOTED OTHERWISE.
25. UNLESS SPECIFICALLY NOTED OTHERWISE, ALL STREET CATCHBASINS SHALL BE INSTALLED WITH TWO - 3.0m MINIMUM SUBDRAINS INSTALLED LONGITUDINALLY, PARALLEL WITH THE CURB. ALL CATCHBASINS IN ASPHALT AREAS, NOT ADJACENT TO A CURB, SHALL BE INSTALLED WITH FOUR - 3.0m MINIMUM SUBDRAINS INSTALLED ORTHOGONALLY.
26. INLET CONTROL DEVICES SHALL BE INSTALLED PRIOR TO COMPLETING THE ROAD BASE (GRANULAR A).
27. ALL SEWER SERVICE LATERALS WITH MAINLINE CONNECTIONS DEEPER THAN 5.0m REQUIRE A CONTROLLED SETTLEMENT JOINT.
28. EACH BUILDING SHALL BE EQUIPPED WITH A SANITARY AND STORM SEWER BACKWATER VALVE AND CLEAN-OUT ON ITS PRIMARY SERVICE, IF REQUIRED BY ONTARIO BUILDING CODE REQUIREMENTS (BY OTHERS).
29. THE SUBGRADE OF ALL STRUCTURES, PIPE, ROADS, SIDEWALKS, WALKWAYS, AND BUILDINGS SHALL BE INSPECTED BY THE GEOTECHNICAL ENGINEER PRIOR TO PROCEEDING WITH CONSTRUCTION.
30. TOP COURSE ASPHALT SHALL NOT BE PLACED UNTIL THE FINAL CCTV INSPECTION AND NECESSARY REPAIRS HAVE BEEN COMPLETED TO THE SATISFACTION OF THE ENGINEER AND THE CITY OF OTTAWA.

CLIENT

Urbandale CORPORATION

2193 Arch Street, Ottawa, ON
K1G 2H5

COPYRIGHT
This drawing has been prepared solely for the intended use, thus any reproduction or distribution for any purpose other than authorized by Arcadis is forbidden. Written dimensions shall have precedence over scaled dimensions. Contractors shall verify and be responsible for all dimensions and conditions on the job, and Arcadis shall be informed of any variations from the dimensions and conditions shown on the drawing. Shop drawings shall be submitted to Arcadis for general conformance before proceeding with fabrication.

ISSUES

No.	DESCRIPTION	DATE
1	ISSUED FOR COORDINATION	2026-06-08
2	SUBMISSION FOR SPA	2026-06-30
3	-	-
4	-	-

NOT FOR CONSTRUCTION

SEE C-010 FOR NOTES, LEGEND, CB TABLE, STREET SECTIONS AND DETAILS

KEY PLAN



CONSULTANTS

SEAL

LICENSED PROFESSIONAL ENGINEER
S. É. LABADIE
100214983
2026/06/30
PROVINCE OF ONTARIO

PROJECT
2604 JESSIE CHENEVERT WALK

50 rte. FLAVENSCENT LANE

PROJECT NO: 30339828

DRAWN BY:	CHECKED BY:
C.C./D.D.	**T.R.B.**
PROJECT MGR: **S.E.L.**	APPROVED BY: **S.E.L.**

SHEET TITLE
NOTES AND LEGEND


SHEET NUMBER	ISSUE
C-010	1

SCALE CHECK — 1:xxxx

PLAN # xxxxx

FILE # D07-xx-xx-xxxx

File Location: C:\Users\hennie6008\DC\ACCDocs\Arcadis ACC US\ACA-30339828-2604 Jessie Chenevert Walk\Project Files\10_WIP\04_CIV\LSheets\C-010 NOTES-LEGEND.dwg Last Saved: June 29, 2026, by hennie6008 Plotted: June 30, 2026 7:54:44 AM by Hennie, Eric

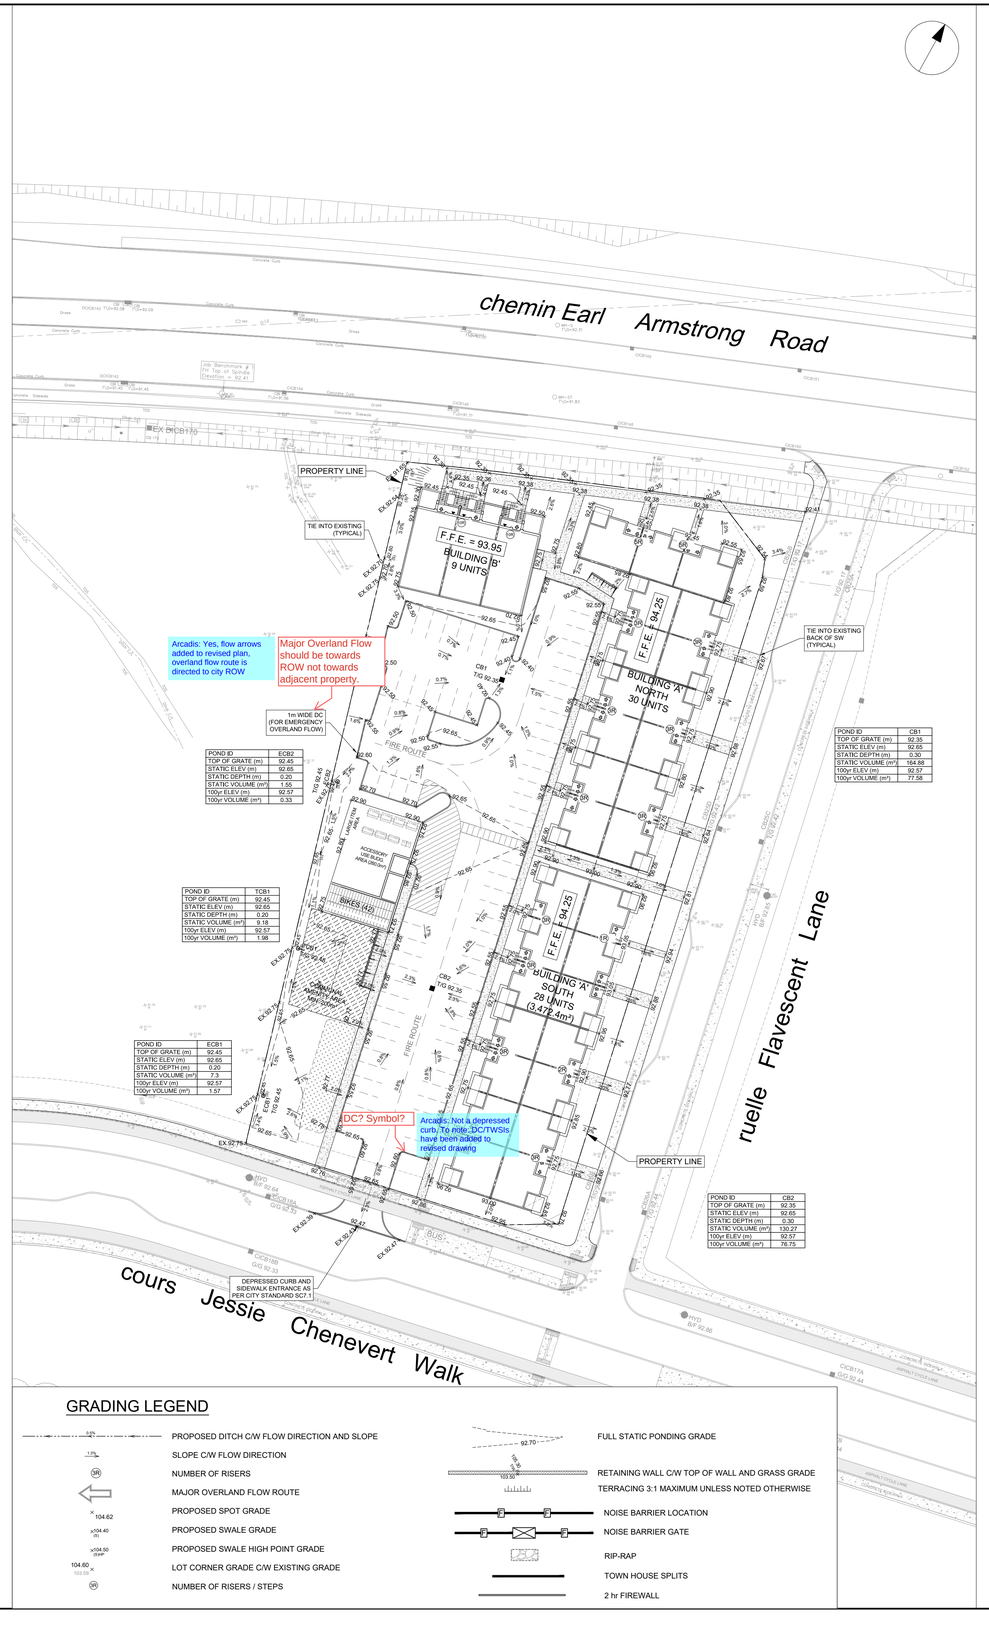

CLIENT

Urbandale CORPORATION

2193 Arch Street, Ottawa, ON
K1G 2H5

COPYRIGHT
This drawing has been prepared solely for the intended use, thus any reproduction or distribution for any purpose other than authorized by Arcadis is forbidden. Written dimensions shall have precedence over scaled dimensions. Contractors shall verify and be responsible for all dimensions and conditions on the job, and Arcadis shall be informed of any variations from the dimensions and conditions shown on the drawing. Shop drawings shall be submitted to Arcadis for general conformance before proceeding with fabrication.

ISSUES

No.	DESCRIPTION	DATE
1	ISSUED FOR COORDINATION	2026-06-08
2	SUBMISSION FOR SPA	2026-06-30
3	-	-
4	-	-

NOT FOR CONSTRUCTION

SEE 0/10 FOR NOTES, LEGEND, CB TABLE, STREET SECTIONS AND DETAILS

KEY PLAN



1:500 0 5 15 25m

CONSULTANTS

SEAL



PROJECT
2604 JESSIE CHENEVERT WALK

PROJECT NO:
30339828

DRAWN BY:	CHECKED BY:
C.C./D.D.	T.R.B.
PROJECT MGR:	APPROVED BY:
S.E.L.	S.E.L.

SHEET TITLE
GRADING - PONDING PLAN

SHEET NUMBER	ISSUE
C-200	1

File Location: C:\Users\hennise6006\DC\ACCDocs\Arcadis ACC US\ACA-30339828-2604 Jessie Chenevert Walk\Project Files\10_VolP04_CIVIL\Sheets\C-200 GRADING PLAN.dwg Last Saved: June 30, 2026, by hennise6006 Plotted: June 30, 2026 7:54:54 AM by Hennie, Eric


FILE # D07-XX-XX-XXXX

PLAN # XXXX

SCALE CHECK 1" = 50mm

LEGEND :

AREA NUMBER
POPULATION
AREA IN HECTARES

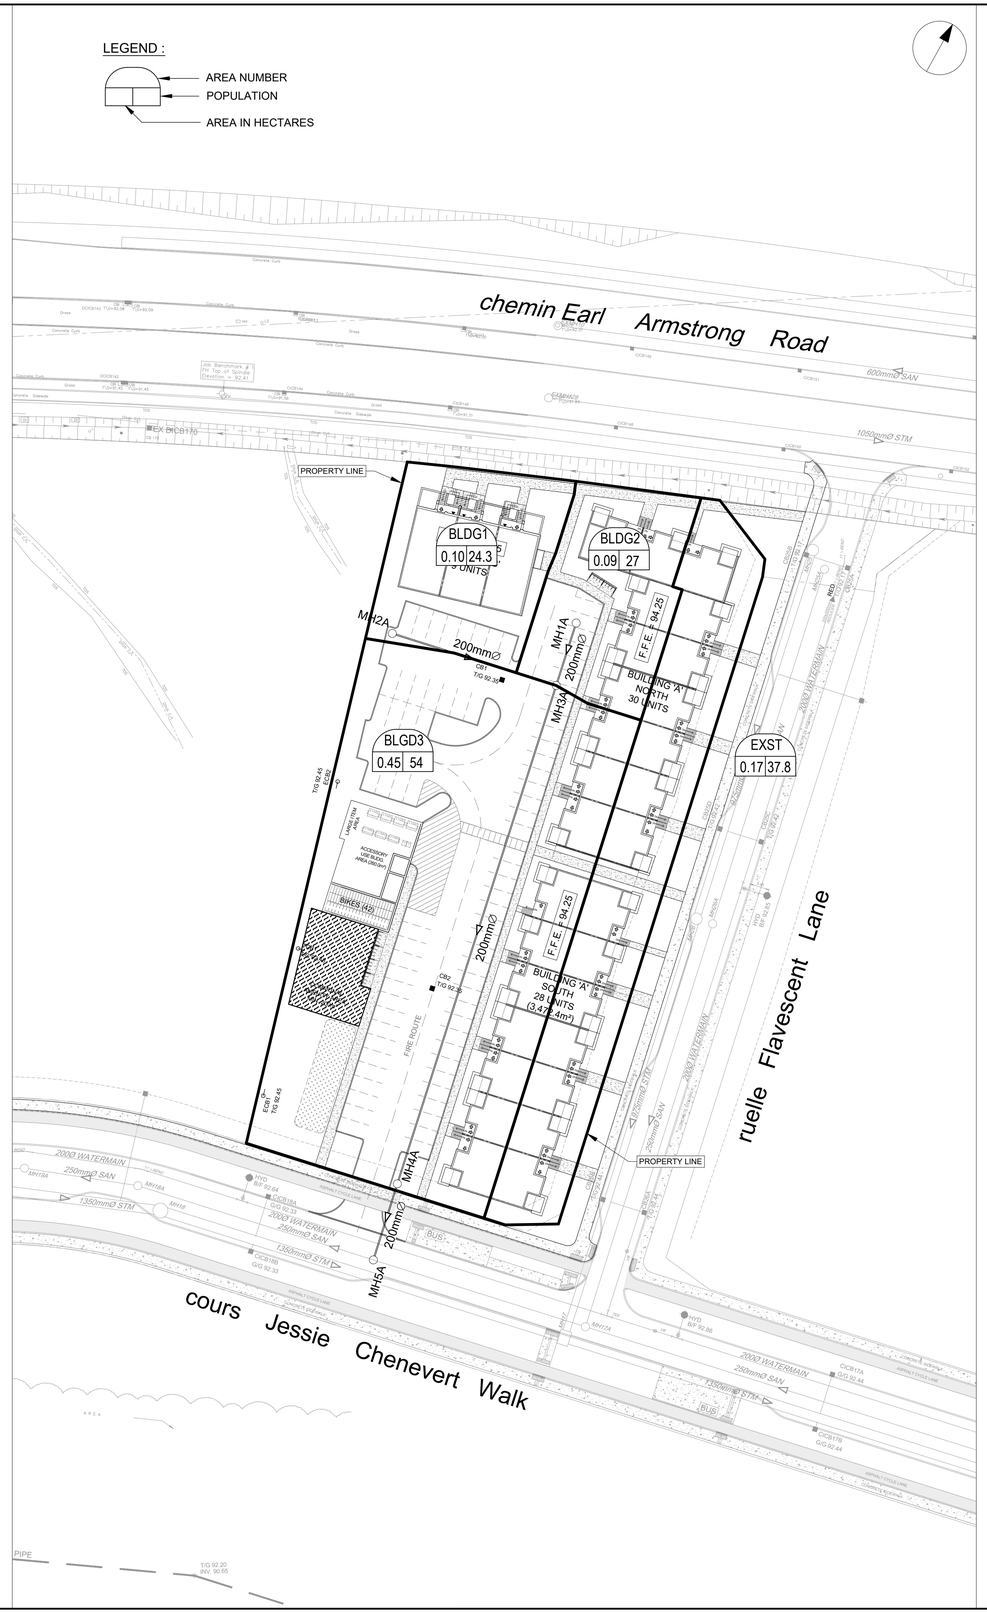

CLIENT

Urbandale CORPORATION

2193 Arch Street, Ottawa, ON
K1G 2H5

COPYRIGHT

This drawing has been prepared solely for the intended use, thus any reproduction or distribution for any purpose other than authorized by Arcadis is forbidden. Written dimensions shall have precedence over scaled dimensions. Contractors shall verify and be responsible for all dimensions and conditions on the job, and Arcadis shall be informed of any variations from the dimensions and conditions shown on the drawing. Shop drawings shall be submitted to Arcadis for general conformance before proceeding with fabrication.


ISSUES

No.	DESCRIPTION	DATE
1	ISSUED FOR COORDINATION	2026-06-08
2	SUBMISSION FOR SPA	2026-06-30
3	-	-
4	-	-

NOT FOR CONSTRUCTION

SEE 010 FOR NOTES, LEGEND, CB TABLE, STREET SECTIONS AND DETAILS

KEY PLAN

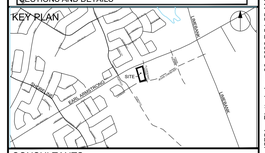

1:500 0 5 10 15 25m

CONSULTANTS

SEAL

LICENSED PROFESSIONAL ENGINEER
S. É. LABADIE
100214983
2026/06/30
PROVINCE OF ONTARIO

PROJECT
2604 JESSIE CHENEVERT WALK

PROJECT NO: 30339828	
DRAWN BY: **C.C./D.D.**	CHECKED BY: **T.R.B.**
PROJECT MGR: **S.E.L.**	APPROVED BY: **S.E.L.**

SHEET TITLE
SANITARY DRAINAGE PLAN

SHEET NUMBER	ISSUE
C-400	1


SCALE CHECK 1:500 — 25mm — PLAN # xxxxx

File Location: C:\Users\hennies6006\DC\ACCDocs\Arcadis ACC US\ACA-30339828-2604 Jessie Chenevert Walk\Project Files\10_WIP\04_CIVIL\Sheets\C-400 SANITARY DRAINAGE PLAN.dwg Last Saved: June 17, 2026, by dones5754 Plotted: June 30, 2026 7:54:55 AM by Hennin, Eric

FILE # D07-XX-XX-XXXX

LEGEND :

AREA NUMBER
RUNOFF COEFFICIENT
AREA IN HECTARES

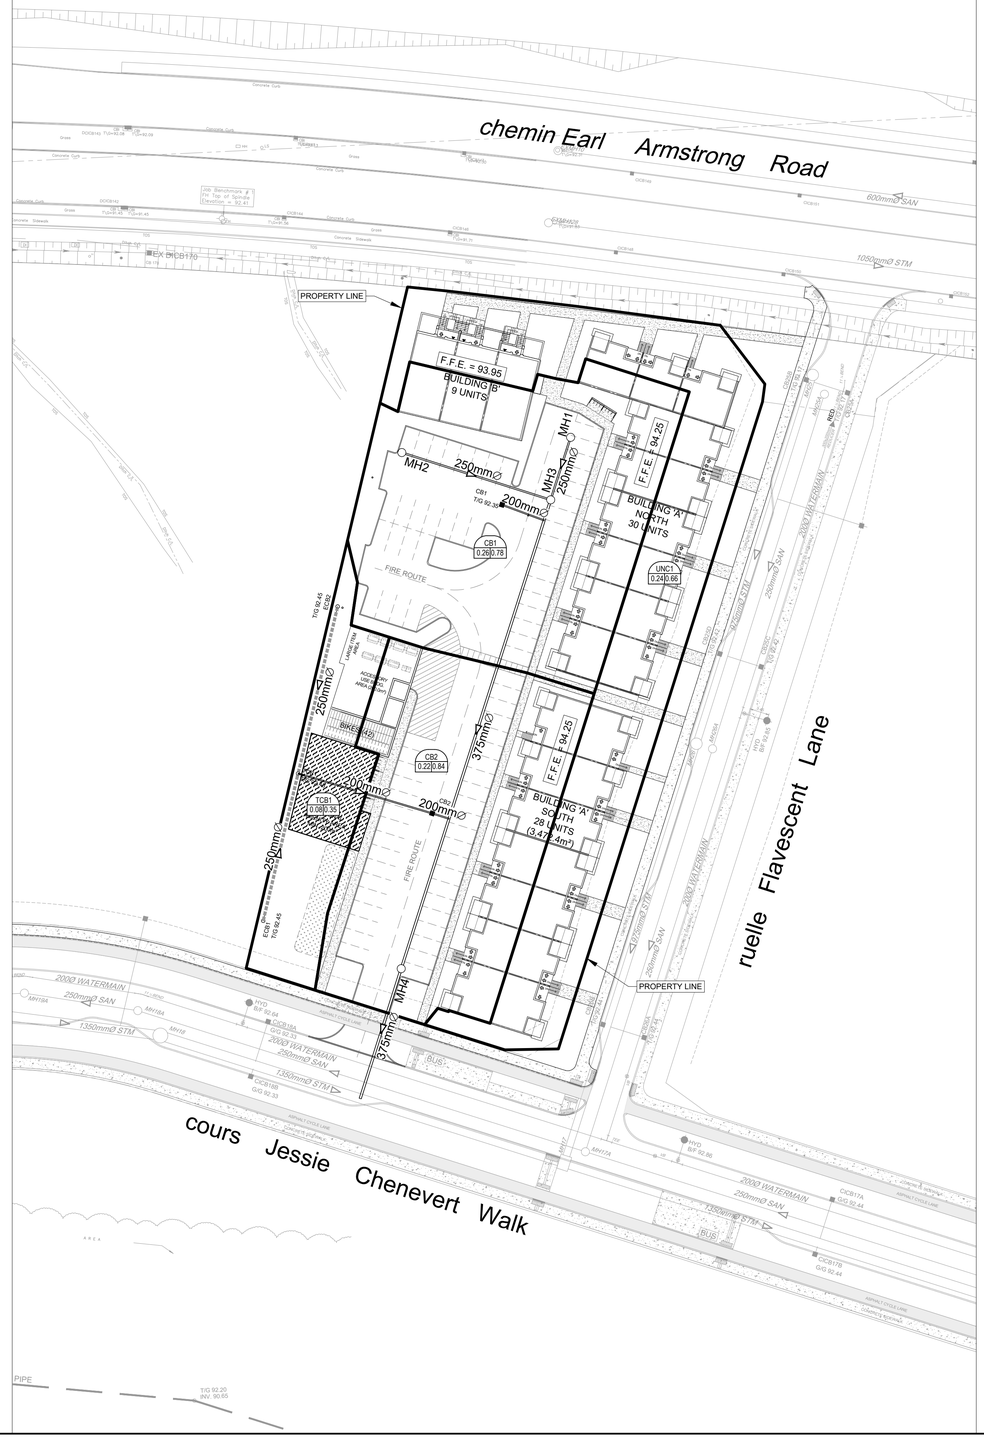

CLIENT

Urbandale CORPORATION

2193 Arch Street, Ottawa, ON
K1G 2H5

COPYRIGHT

This drawing has been prepared solely for the intended use, thus any reproduction or distribution for any purpose other than authorized by Arcadis is forbidden. Written dimensions shall have precedence over scaled dimensions. Contractors shall verify and be responsible for all dimensions and conditions on the job, and Arcadis shall be informed of any variations from the dimensions and conditions shown on the drawing. Shop drawings shall be submitted to Arcadis for general conformance before proceeding with fabrication.

ISSUES

No.	DESCRIPTION	DATE
1	ISSUED FOR COORDINATION	2026-06-08
2	SUBMISSION FOR SPA	2026-06-30
3	-	-
4	-	-

NOT FOR CONSTRUCTION

SEE 0/10 FOR NOTES, LEGEND, CB TABLE, STREET SECTIONS AND DETAILS

KEY PLAN



CONSULTANTS

1:500 0 5 15 25m

SEAL



PROJECT
2604 JESSIE CHENEVERT WALK

PROJECT NO:
30339828

DRAWN BY:	CHECKED BY:
C.C./D.D.	T.R.B.
PROJECT MGR:	APPROVED BY:
S.E.L.	S.E.L.

SHEET TITLE
STORM DRAINAGE PLAN


SHEET NUMBER	ISSUE
C-500	1

SCALE CHECK | 1cm

PLAN # xxxxx


FILE # D07-xx-xx-xxxx

File Location: C:\Users\hennie8009\DC\ACCDocs\Arcadis ACC US\ACA-30339828-2604 Jessie Chenevert Walk\Project Files\10_WIP\04_CIVIL\Sheets\C-500 STORM DRAINAGE PLAN.dwg Last Saved: June 12, 2026, by vaghelad4623 Plotted: June 30, 2026 7:55:04 AM by Hennie, Eric

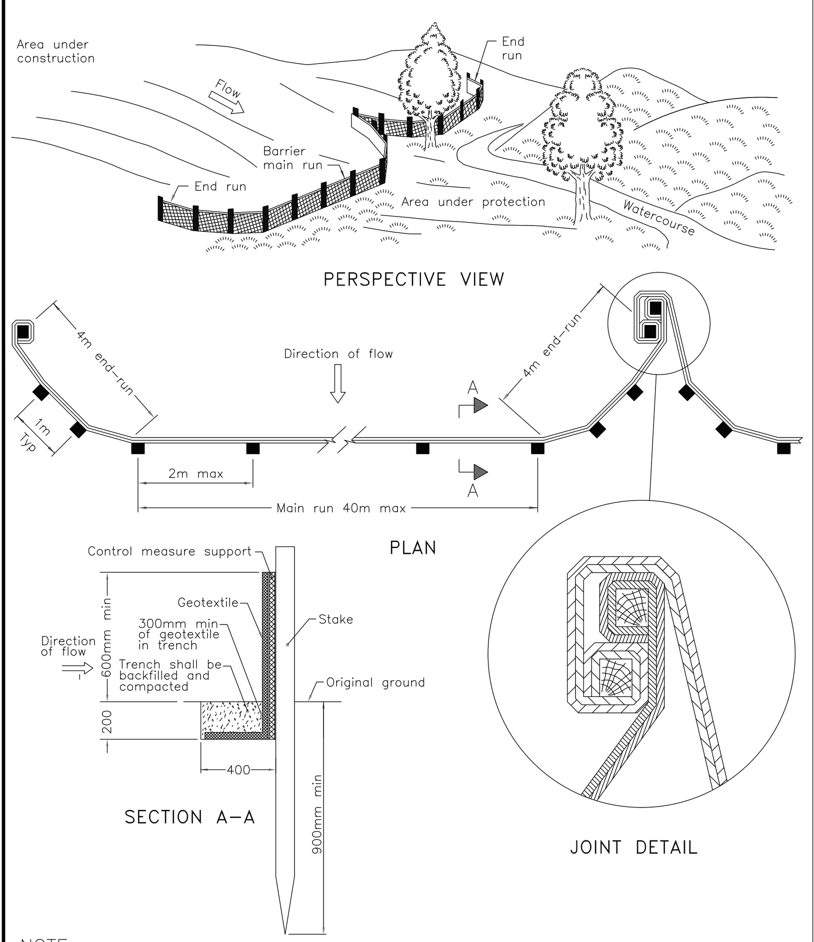


NOTE:
A All dimensions are in millimetres unless otherwise shown.

ONTARIO PROVINCIAL STANDARD DRAWING	Nov 2021	Rev 3
HEAVY–DUTY SILT FENCE BARRIER	OPSD 219.130	

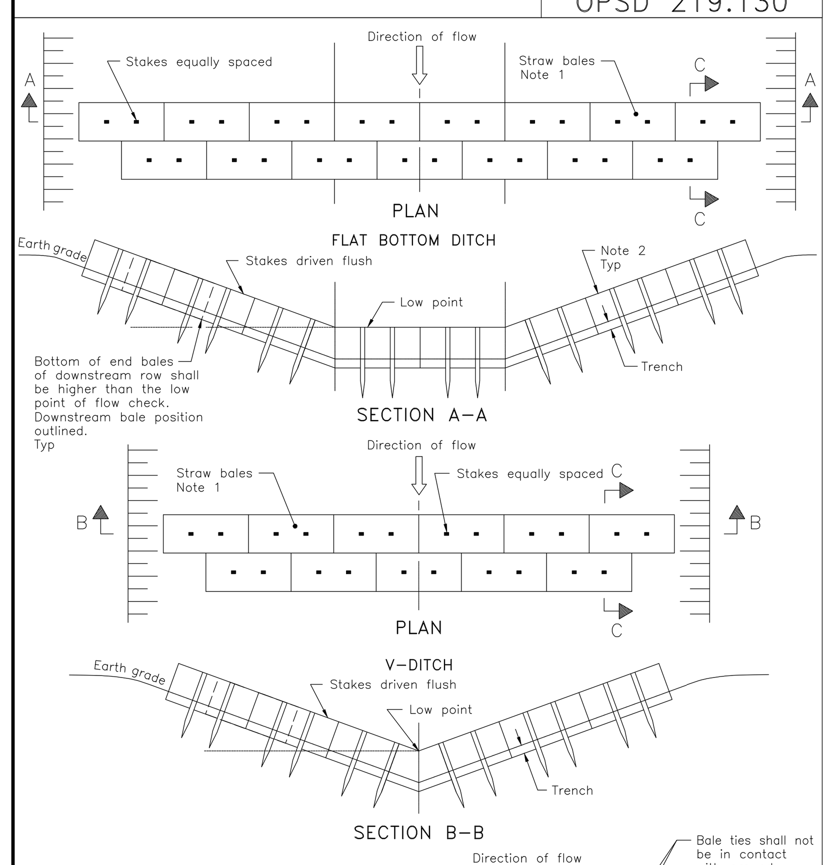

NOTES:
1 Number of bales varies and shall suit ditch.
2 Straw bales shall be butted tightly against adjoining bales and shaped to conform to the sides of the ditch to prevent water flow through barrier.
A Fill and compact gaps with loose straw.
B All dimensions are in millimetres unless otherwise shown.

ONTARIO PROVINCIAL STANDARD DRAWING	Nov 2021	Rev 3
STRAW BALE FLOW CHECK DAM	OPSD 219.180	

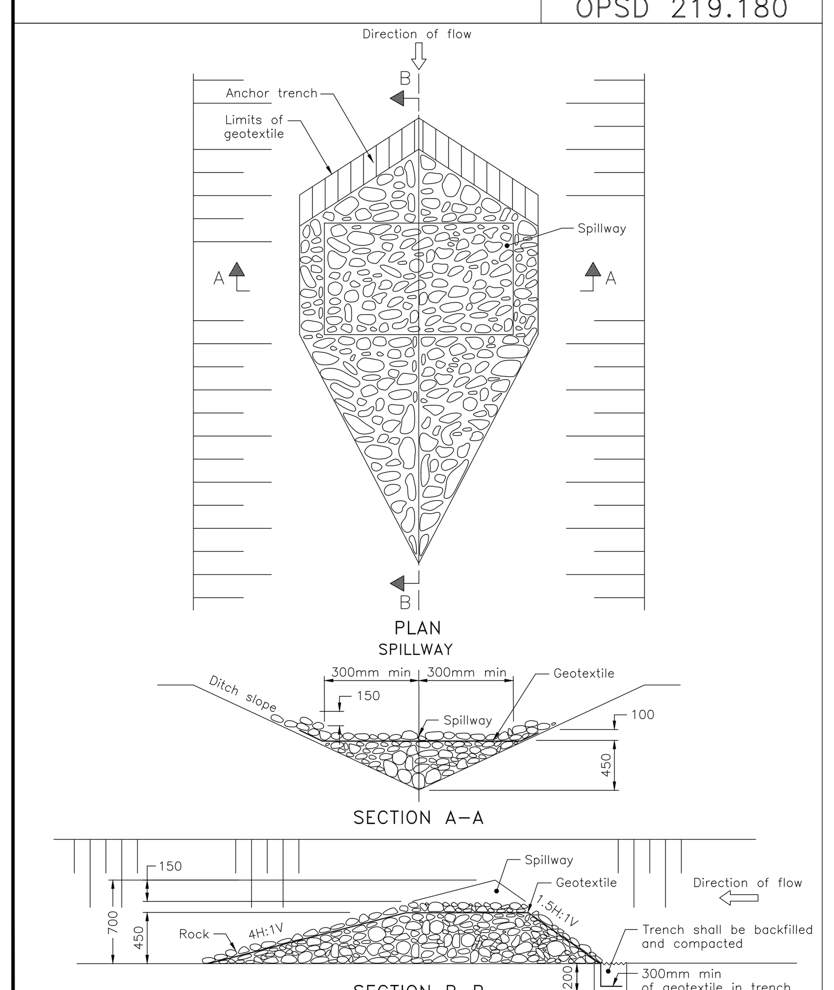

NOTE:
A All dimensions are in millimetres unless otherwise shown.


ONTARIO PROVINCIAL STANDARD DRAWING	Nov 2022	Rev 3
TEMPORARY ROCK FLOW CHECK DAM V–DITCH	OPSD 219.210	

NOTES:

1. THE CONTRACTOR SHALL IMPLEMENT BEST MANAGEMENT PRACTICES, TO PROVIDE FOR PROTECTION OF THE AREA DRAINAGE SYSTEM AND THE RECEIVING WATERCOURSE, DURING CONSTRUCTION ACTIVITIES. THE CONTRACTOR ACKNOWLEDGES THAT FAILURE TO IMPLEMENT APPROPRIATE EROSION AND SEDIMENT CONTROL MEASURES MAY BE SUBJECT TO PENALTIES IMPOSED BY ANY APPLICABLE REGULATORY AGENCY.
2. SILT FENCE TO BE ERECTED PRIOR TO EARTH WORKS BEING COMMENCED. SILT FENCE TO BE MAINTAINED UNTIL VEGETATION IS ESTABLISHED OR UNTIL START OF SUBSEQUENT PHASE.
3. STRAW BALE SEDIMENT TRAPS TO BE CONSTRUCTED IN EXISTING ROAD SIDE DITCHES. TRAPS TO REMAIN AND BE MAINTAINED UNTIL VEGETATION IS ESTABLISHED.
4. FILTER CLOTH TO BE PLACED AND MAINTAINED UNDER COVER OF ALL PROPOSED CATCHBASINS AFTER BASE COURSE, AND EXISTING CATHBASINS IDENTIFIED OUTSIDE OF CONSTRUCTION LIMIT. FILTER CLOTH IN STREET CB'S TO REMAIN UNTIL ALL CURBS ARE CONSTRUCTED. FILTER CLOTH IN RYCB'S TO REMAIN UNTIL VEGETATION IS ESTABLISHED. ALL CATHCBASINS TO BE REGULARLY INSPECTED AND CLEANED AS NECESSARY, UNTIL SOD AND CURBS ARE CONSTRUCTED.
5. CONTRACTOR TO PROVIDE DETAILS ON LOCATION(S) AND DESIGN OF DEWATERING TRAP(S) PRIOR TO COMMENCING WORK. CONTRACTOR ALSO RESPONSIBLE FOR MAINTAINING TRAP(S) AND ADJUSTING SIZE(S) IF DEEMED REQUIRED BY THE ENGINEER DURING CONSTRUCTION.
6. WORKS NOTED ABOVE ARE TO BE INSTALLED, INSPECTED, MAINTAINED AND ULTIMATELY REMOVED BY SERVICING CONTRACTOR.
7. THIS IS A "LIVING DOCUMENT" AND MAY BE MODIFIED IN THE EVENT THE PROPOSED CONTROL MEASURES ARE INSUFFICIENT.

LEGEND:

- HEAVY DUTY SILT FENCE AS PER OPSD-219.130
- SNOW FENCE
- STRAW BALE CHECK DAM AS PER OPSD-219.180
- ROCK CHECK DAM AS PER OPSD-219.210
- FILTER CLOTH PLACED UNDER EXISTING CB COVER
- TEMPORARY MUD MAT 0.15m THICK 50mm CLEAR STONE ON NON WOVEN FILTER CLOTH (15.0m × 7.00)

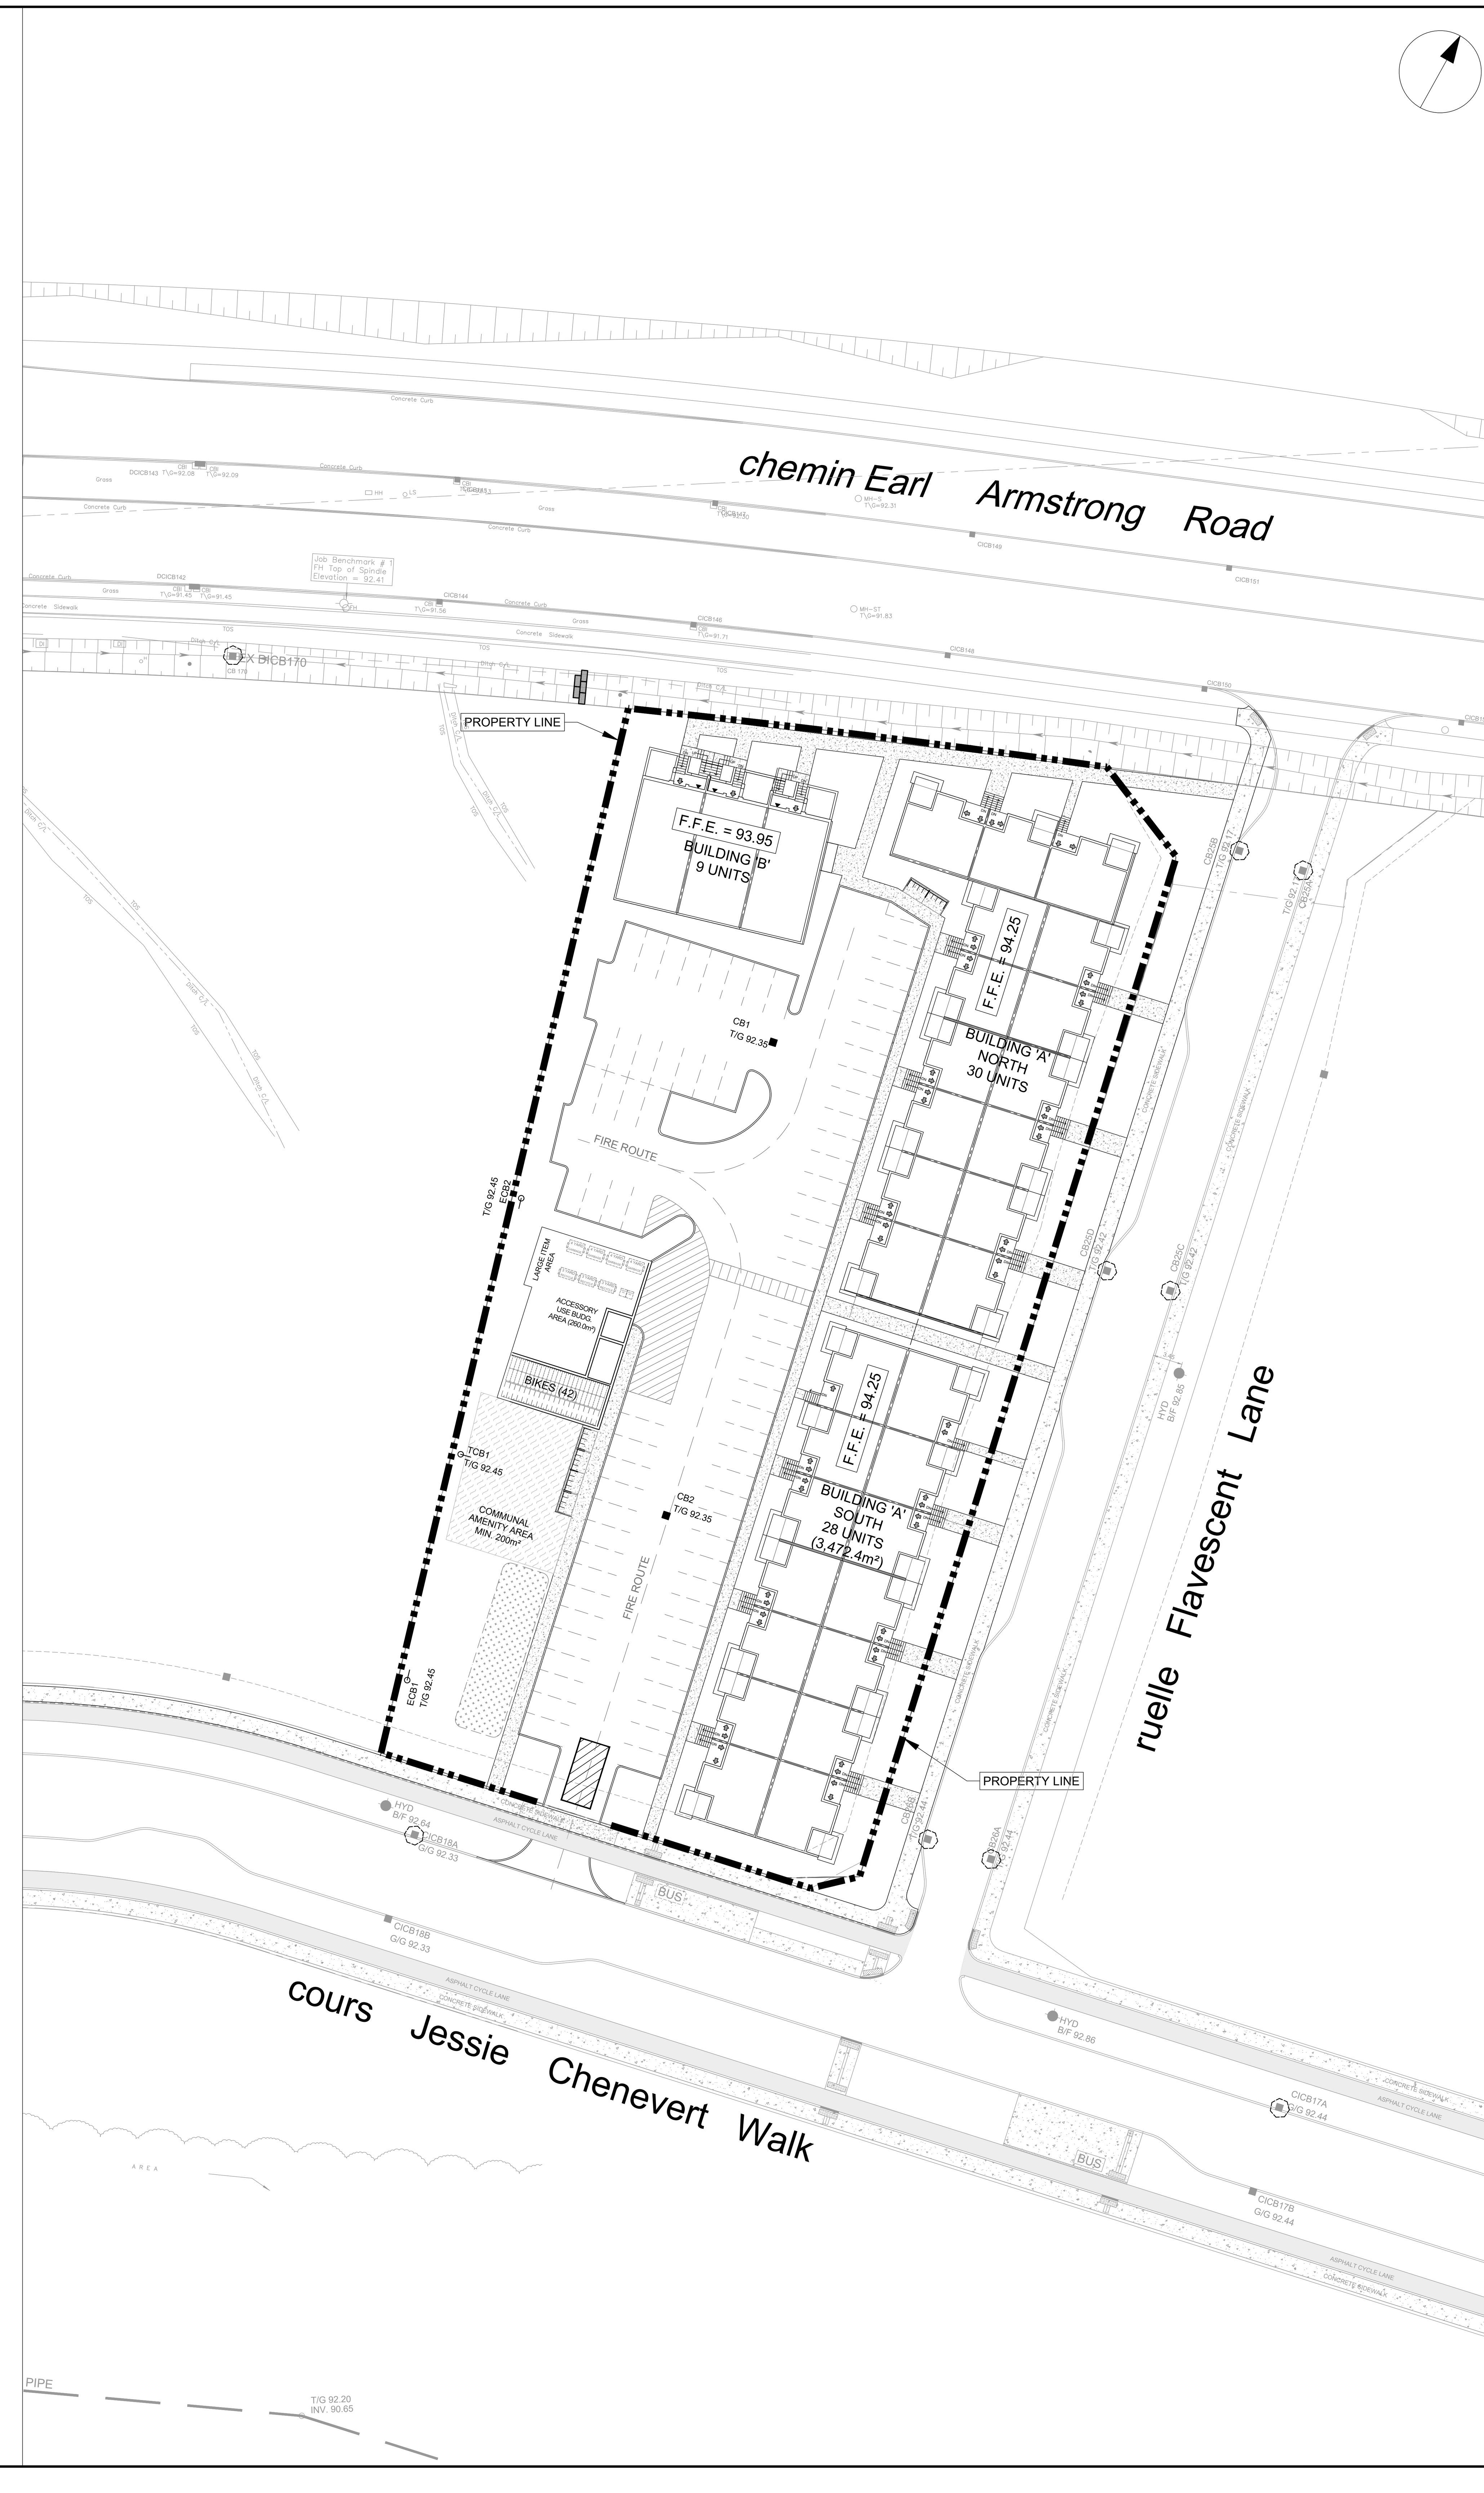

CLIENT

Urbandale CORPORATION

2193 Arch Street, Ottawa, ON
K1G 2H5

COPYRIGHT
This drawing has been prepared solely for the intended use, thus any reproduction or distribution for any purpose other than authorized by Arcadis is forbidden. Written dimensions shall have precedence over scaled dimensions. Contractors shall verify and be responsible for all dimensions and conditions on the job, and Arcadis shall be informed of any variations from the dimensions and conditions shown on the drawing. Shop drawings shall be submitted to Arcadis for general conformance before proceeding with fabrication.


ISSUES

No.	DESCRIPTION	DATE
1	ISSUED FOR COORDINATION	2026-06-08
2	SUBMISSION FOR SPA	2026-06-30
3	-	-
4	-	-

NOT FOR CONSTRUCTION

SEE 010 FOR NOTES, LEGEND, CB TABLE, STREET SECTIONS AND DETAILS

KEY PLAN

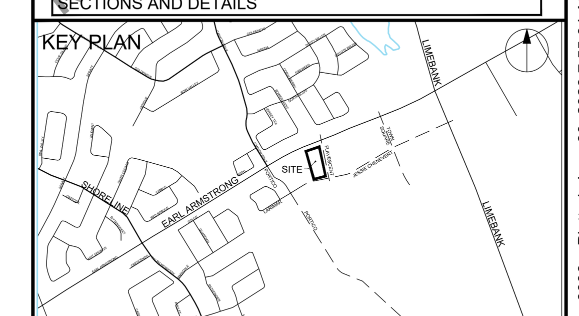

CONSULTANTS

1:500 0 5 15 25m

SEAL

LICENSED PROFESSIONAL ENGINEER
S. E. LABADIE
100214983
2026/06/30
PROVINCE OF ONTARIO

PROJECT
2604 JESSIE CHENEVERT WALK

50 rte. FLAVENSCENT LANE

PROJECT NO: 30339828	
DRAWN BY: C.C./D.D.	CHECKED BY: T.R.B.
PROJECT MGR: S.E.L.	APPROVED BY: S.E.L.

SHEET TITLE
EROSION - SEDIMENT PLAN

SHEET NUMBER	ISSUE
C-900	1

File Location: C:\Users\henriee6006\DC\ACCDocs\Arcadis ACC US\ACA-30339828-2604 Jessie Chenevert Walk\Project Files\10_WIP\04_CIVIL\Sheets\C-900 EROSION - SEDIMENT PLAN.dwg Last Saved: June 29, 2026, by henriee6006 Plotted: June 30, 2026 7:55:04 AM by Henrie, Eric

SCALE CHECK 1 in 10mm

FILE # D07-XX-XX-XXXX

PLAN # XXXXX