

Notes:



PHASES 3 & 4


SINGLE INTERSECTION NARROWING PER R8 (TYPICAL)

DOUBLE INTERSECTION NARROWING PER R7 (TYPICAL)

PHASE 2B

PHASE 1 & 2A

PARK 3.09 Ha

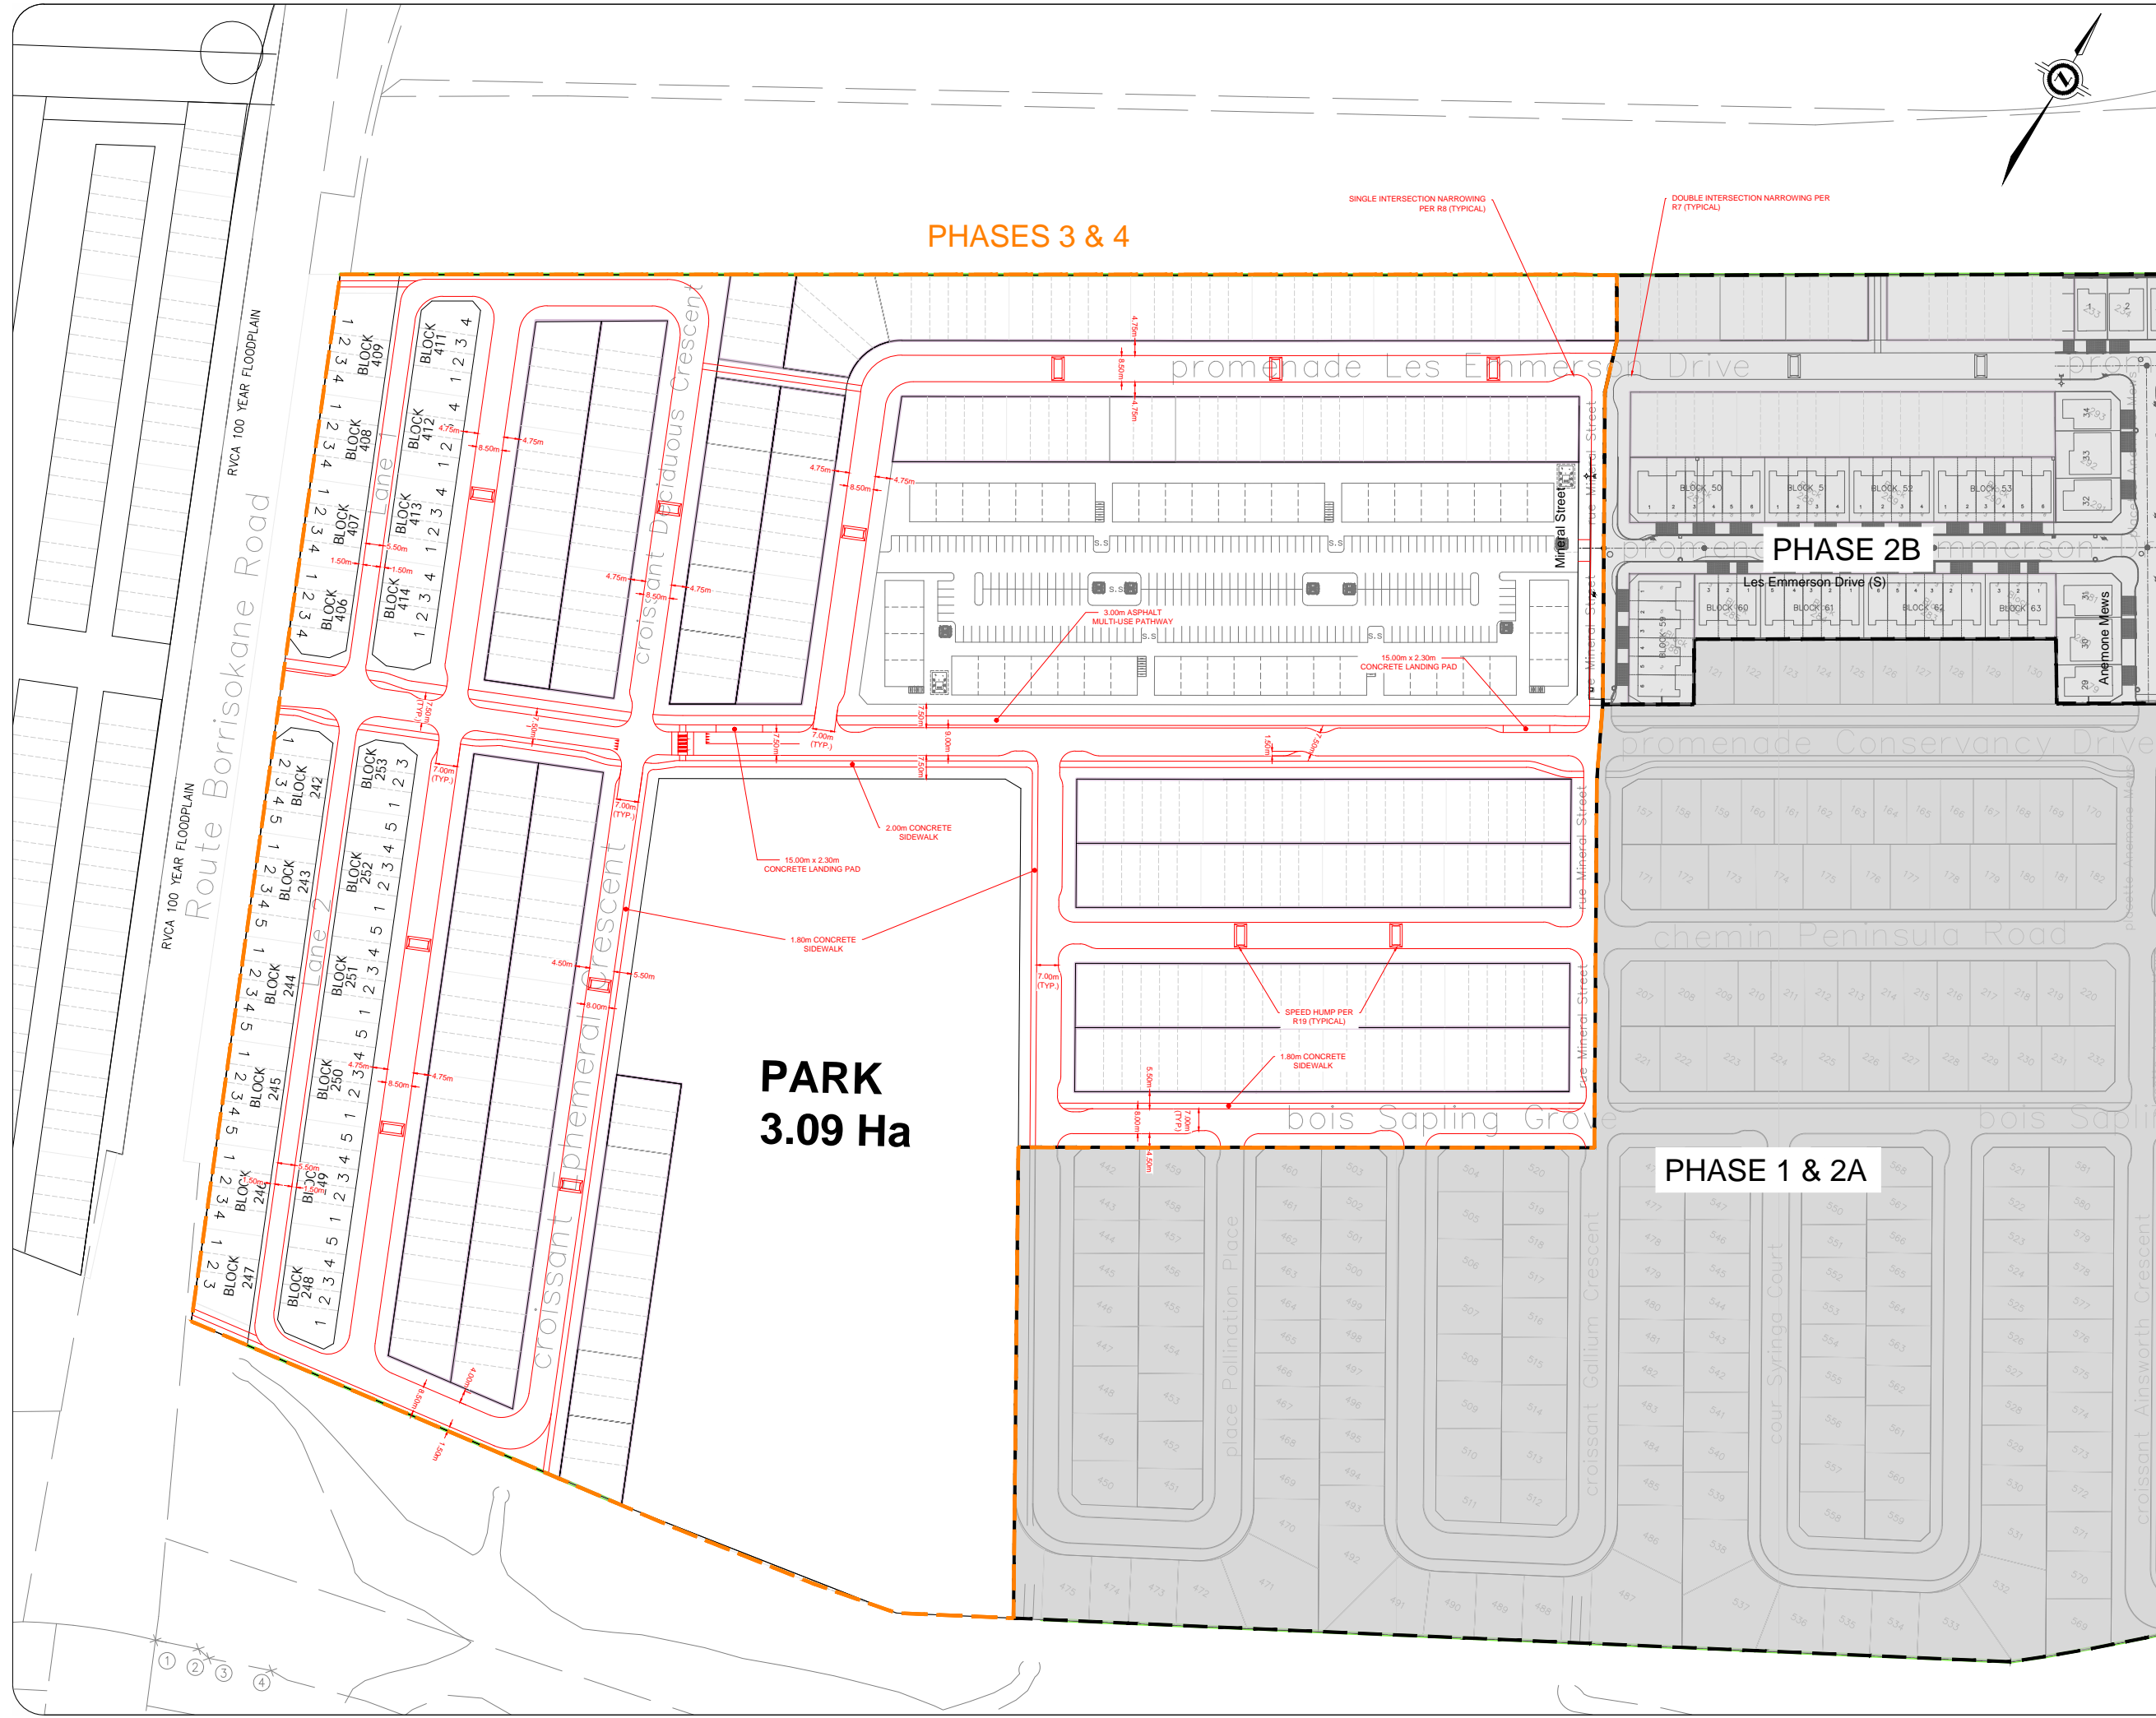

01	Issued for Review	BB	2024-04-03
REV:	DESCRIPTION:	BY:	DATE:
STATUS:			



6 Plaza Court
Ottawa, ON
K2H 7W1
(343) 999-9117

CLIENT: Caivan Communities

ARCHITECT:

SITE: Caivan Conservancy East

TITLE: Conservancy East
Phases 3/4 Redline

SCALE AT A3:	DATE:	DRAWN:	CHECKED:
NTS	2024-04-03	BB	AL
PROJECT NO:	DRAWING NO:	REVISION:	
2022-008	001	01	